
U.S. PUBLIC LAND SURVEY MONUMENT RECORD

(b) (f) (g) (h) Description of monument found at this corner and if it was accepted, state all evidence (material, testimonial, occupational, plats, records, other monuments) used as a basis for accepting. If not accepted or if nothing was found, state evidence used as basis for establishing location. If reestablished through lost corner proportionate methods, indicate all monuments, distances and directions used to establish.

Found P.K. spike at interesection of C.T.H.Z & Scott Road. Dug hole 8' \times 10', 3.5 feet deep. Found no evidence of corner. Set Berntsen monument at location of P.K. spike.

(c) (d) (e) Plan view of corner with ties to at least 4 witness monuments. If in disagreement with previously established corner, show the distances between the two corners and also indicate the ties to the disputed corner.

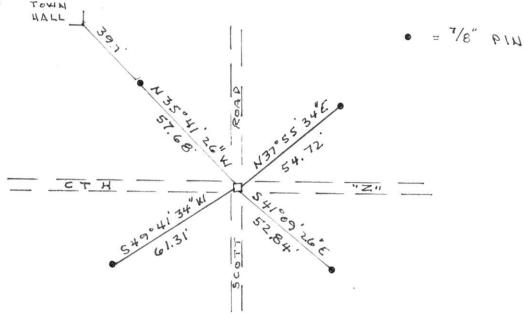

(i) I,_____Robert K. Fergot

(type or print name) certify that the corner location on this record was determined by me or under my direction and control and that this U.S. Public Land Survey Monument Record is correct and complete to the best of my knowledge and belief.

Robert K. Forgot
Signature

Oct 7,1997

Date



Index No. Q - 13

21

Section.