

# U.S. PUBLIC LAND SURVEY MONUMENT RECORD


Note: This form is intended and designed to fulfill all requirements of Wisconsin Administrative Code, Chapter A-E 5.02, U.S. Public Land Survey Monument Record (3) (a) (b) (c) (d) (e) (f) (g) (h) (i). An additional sheet may be added if necessary to conform with said requirements.

(a) Corner location: Township 31 North

Range 6 East

Town/City/Village Scott

County Lincoln

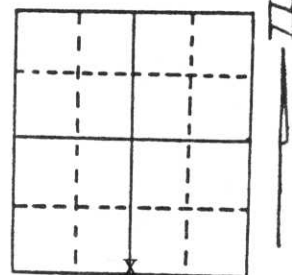


Section 26

(b) (f) (g) (h) Description of monument found at this corner and if it was accepted, state all evidence (material, testimonial, occupational, plats, records, other monuments) used as a basis for accepting. If not accepted or if nothing was found, state evidence used as basis for establishing location. If reestablished through lost corner proportionate methods, indicate all monuments, distances and directions used to establish.

We dug for the corner and found no evidence of a monument. I placed a Bernsten Monument at the centerline of River Road and a even split between the assumed Southwest Corner of Sec. 26 and the assumed Southeast Corner of Sec.26. This position fit an old Southbound fenceline.

(c) (d) (e) Plan view of corner with ties to at least 4 witness monuments. If in disagreement with previously established corner, show the distances between the two corners and also indicate the ties to the disputed corner.

## SOUTH 1/4 CORNER SEC. 26

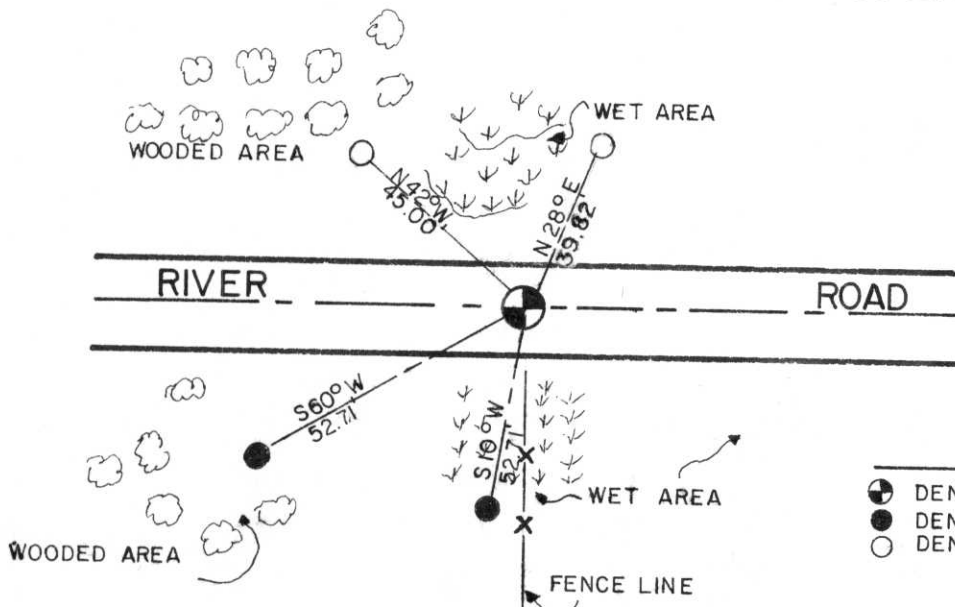

### LEGEND

- DENOTES BERNSTEN MONUMENT SET.
- DENOTES 1"X30" REBAR SET.
- DENOTES 1"X24" PIPE SET.

(i) I, Thomas A. Radenz  
(type or print name) certify that the corner location on this record was determined by me or under my direction and control and that this U.S. Public Land Survey Monument Record is correct and complete to the best of my knowledge and belief.

Thomas A. Radenz  
Signature

1-3-94  
Date



Index No. 0-19