U.S. PUBLIC LAND SURVEY MONUMENT RECORD


Note: This form is intended and designed to fulfill all requirements of Wisconsin Administrative Code, Chapter A-E 5.02, U.S. Public Land Survey Monument Record (3) (a) (b) (c) (d) (e) (f) (g) (h) (i). An additional sheet may be added if necessary to

(a) Corner location: Township 31 North

Range 6 East

Town ____ SCOTT


County ____LINCOLN

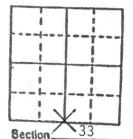

b) (f) (g) (h) Description of monument found at this corner and if it was accepted, state all evidence (material, testimonial, occupational, plats, records, other monuments) used as a basis for accepting. If not accepted or if nothing was found, state evidence used as basis for establishing location. If reestablished through lost corner proportionate methods, indicate all monuments, distances and directions used to establish.

Lincoln County Highway Commissioner would not let me dig for this corner. Held center line intersection at Scott Road and Hwy "FF" (approximate SE Cor.) split distance and set this corner. Set 1" Iron Bar in road, flush with surface. Tied out. This matched 40 fence to West very well. Held for corner.

c) (d) (e) Plan view of corner with ties to at least 4 witness monuments. If in disagreement with previously established corner, show the distances between the two corners and also indicate the ties to the disputed corner.

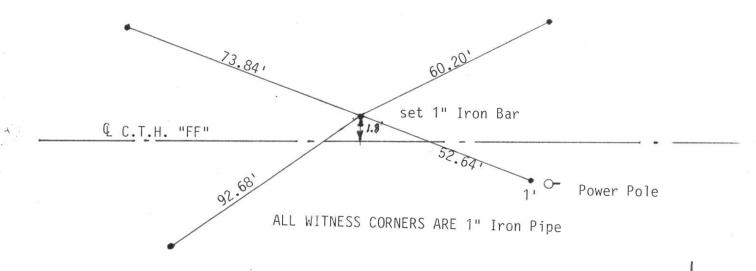

(i) I. David L. Osterbrink RLS No. S-2014

(type or print name) certify that the corner location on this record was determined by me or under my direction and control and that this U.S. Public Land Survey Monument Record is correct and complete to the best of my knowledge and belief.

Signature

6-1-94

Date

RECEIVED AT LINCOLN COUNTY

COURTHOUSE THIS 314 DA

Pat Prube

DAVID L.
OSTERBRINK
S-2014
WAUSAU
WIS.
SURV

Index No.