

CERTIFIED LAND CORNER RESTORATION

Index No. W-13


State of Wisconsin }
County of Lincoln } ss.

History of original corner establishment:


I Chester J. Nowaczyk do hereby certify that on the 7th day of June, 1979, I found evidence of the E.V.4 corner of Section 33 Township 31, North, Range 6, Fourth, Principal Meridian, as described hereon; and that from this evidence I established a new monument and accessories as described hereon to perpetuate the original location of this corner.

Resident witnesses:

.....
.....
.....

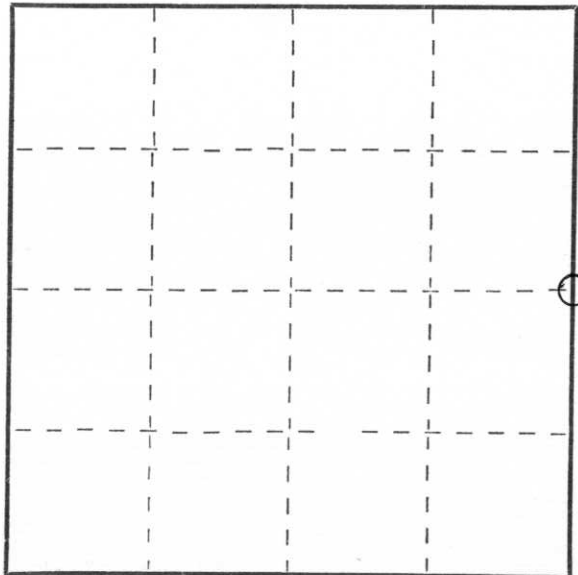

○ = Corner monument restored.

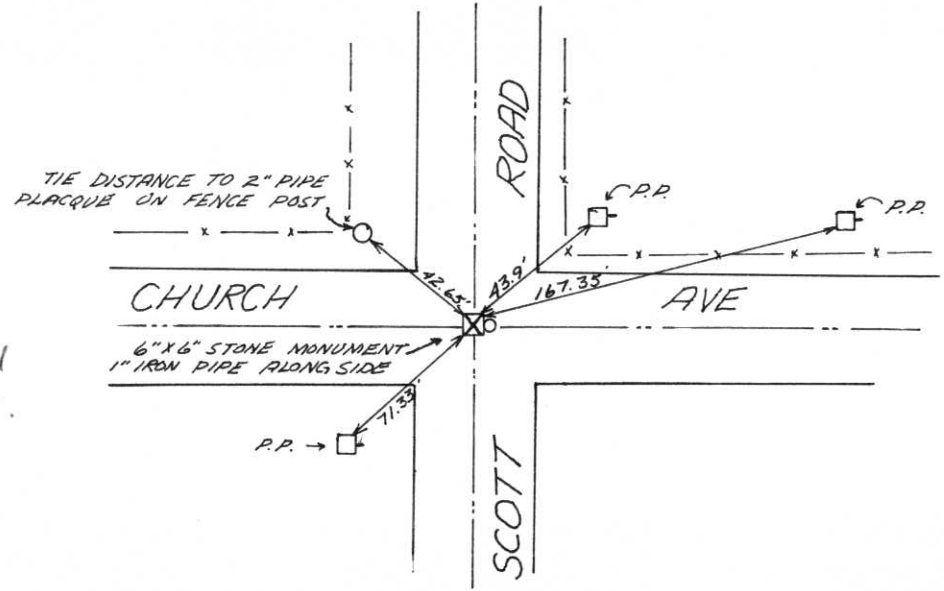

Description of corner evidence found:
Dug with backhoe, found 6\"/>

Description of monument and accessories I established to perpetuate the original location of this corner.



Dated at 1, Wis., this 7th day of JUNE, 1979.

Signature Chester J. Nowaczyk Title SURVEYOR Registration No. 51143
(County Surveyor, Registered Land Surveyor, or other duly authorized official)

Office of Register of Deeds, County of _____, I hereby certify that the within instrument was filed in this office for record on the _____ day of _____, 19____ at _____ o'clock _____ M.

.....
(Register of Deeds)

By _____ Deputy