


Project I.D. 1173-2-00 So. Co. Line  
 -1.4MI. N. Merrill U.S.H. 51  
 Freeway Lincoln County Wm. Scheuer  
 Surveyor Received from Division of  
 Hw's Jan. 11. 1973

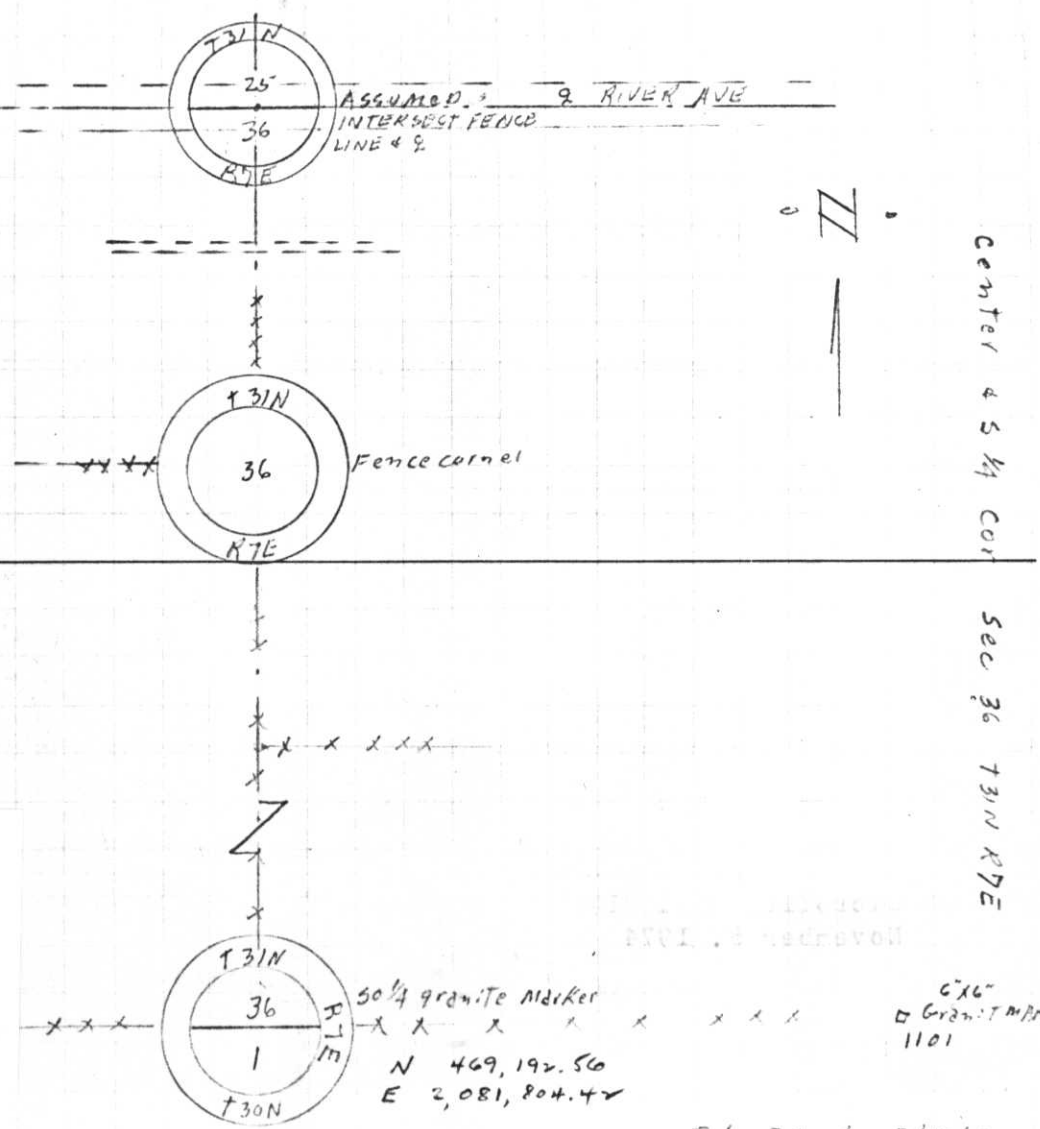

Ties gone  
 per Aero-metric  
 10/98

36-31-6 3/27/02 TD

K-23

1972