

U.S. PUBLIC LAND SURVEY MONUMENT RECORD


Note: This form is intended and designed to fulfill all requirements of Wisconsin Administrative Code, Chapter A-E 5.02, U.S. Public Land Survey Monument Record (3) (a) (b) (c) (d) (e) (f) (g) (h) (i). An additional sheet may be added if necessary to conform with said requirements.

(a) Corner location: Township 31 North

Range 7 East

Town/City/Village PINE RIVER

County LINCOLN

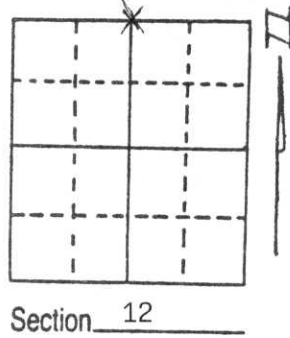

(b) (f) (g) (h) Description of monument found at this corner and if it was accepted, state all evidence (material, testimonial, occupational, plats, records, other monuments) used as a basis for accepting. If not accepted or if nothing was found, state evidence used as basis for establishing location. If reestablished through lost corner proportionate methods, indicate all monuments, distances and directions used to establish.


Did not dig for corner because of some 20 to 30 feet of fill in area and under lying culverts. Lines of occupation and centerline of C.T.H. "G" was held as best evidence of corner location. Set PK Nail and tied out.

**RECEIVED AT LINCOLN COUNTY
COURTHOUSE THIS 26th DAY
OF Dec. 19 96
Pat Priske
TAX DESCRIPTION OFFICE**

(c) (d) (e) Plan view of corner with ties to at least 4 witness monuments. If in disagreement with previously established corner, show the distances between the two corners and also indicate the ties to the disputed corner.

All ties 7/8" x 30" Rebars
Tie to SW has DO NOT DISTURB SIGN

Ties completed 11-7-96

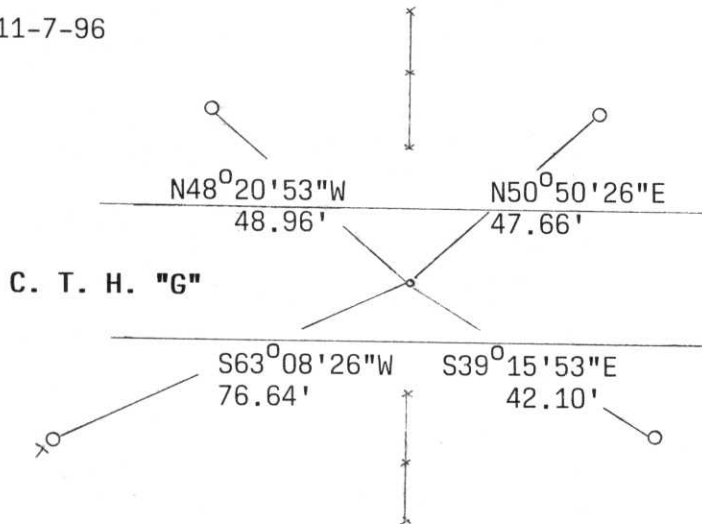

TO NW Cor. N89°55'50"W,
2636.84'
TO NE Cor. S89°53'53"E,
2619.53'

No Scale

(i) I, Gary R. Krueger RLS NO.1619
(type or print name) certify that the corner location on this record was determined by me or under my direction and control and that this U.S. Public Land Survey Monument Record is correct and complete to the best of my knowledge and belief.

Gary R. Krueger 12-19-96
Signature Date



Index No. E-23