


U.S. PUBLIC LAND SURVEY MONUMENT RECORD

Note: This form is intended and designed to fulfill all requirements of Wisconsin Administrative Code, Chapter A-E 5.02, U.S. Public Land Survey Monument Record (3) (a) (b) (c) (d) (e) (f) (g) (h) (i). An additional sheet may be added if necessary to conform with said requirements.

(a) Corner location: Township 31 North
 Range 7 East

Town/City/Village PINE RIVER

County LINCOLN

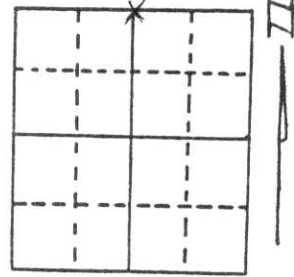

Section 11

(b) (f) (g) (h) Description of monument found at this corner and if it was accepted, state all evidence (material, testimonial, occupational, plats, records, other monuments) used as a basis for accepting. If not accepted or if nothing was found, state evidence used as basis for establishing location. If reestablished through lost corner proportionate methods, indicate all monuments, distances and directions used to establish.


Dug with backhoe on 10-30-96 and found 6" x 6" Granite Stone Monument 2.3 feet below the road surface. Placed Iron Bar over stone and tied out.

**RECEIVED AT LINCOLN COUNTY
 COURTHOUSE THIS 26th DAY
 OF Dec. 19 96
Pat Priebe
 TAX DESCRIPTION OFFICE**

(c) (d) (e) Plan view of corner with ties to at least 4 witness monuments. If in disagreement with previously established corner, show the distances between the two corners and also indicate the ties to the disputed corner.

Ties completed 11-7-96

All ties to 7/8" x 30" Rebars
 Tie to NW has DO NOT DISTURB SIGN
 Tie to SE is 20' East of Driveway
 Tie to NE is at 4th fence post East

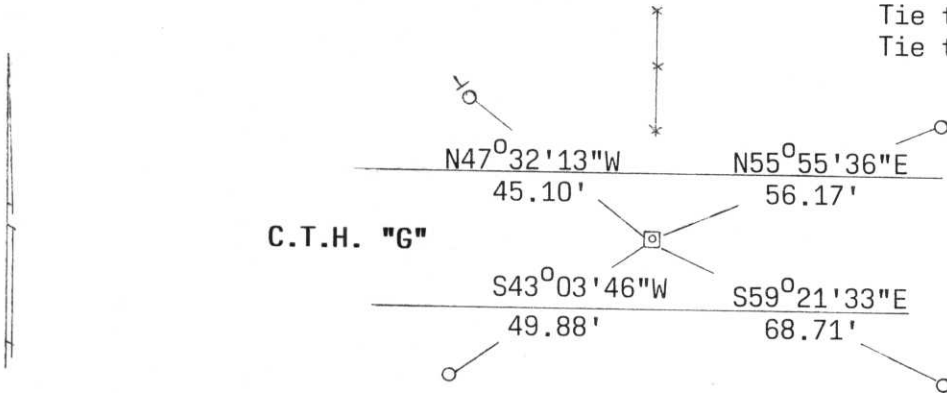

No Scale

To NE Cor. N89°59'12"E, 2641.62'
 To NW Cor. S89°54'10"W, 2693.98'
 To S½ Cor. S0°15'11"E, 5343.75'

(i) I, Gary R. Krueger, Registered Land Surveyor 1619
 (type or print name) certify that the corner location on this record was determined by me or under my direction and control and that this U.S. Public Land Survey Monument Record is correct and complete to the best of my knowledge and belief.

Gary R. Krueger Signature 12-19-96 Date



Index No. E-19