


CERTIFIED LAND CORNER RESTORATION

Index No. E-5

State of Wisconsin }
County of Lincoln } ss.

I Sheridan D. Schwark, do hereby certify that on the _____ day of _____, 1976, I found evidence of the North east corner of Section 7 Township 31, North, Range 7 East, Fourth, Principal Meridian, as described hereon; and that from this evidence I established a new monument and accessories as described hereon to perpetuate the original location of this corner.

Resident witnesses:

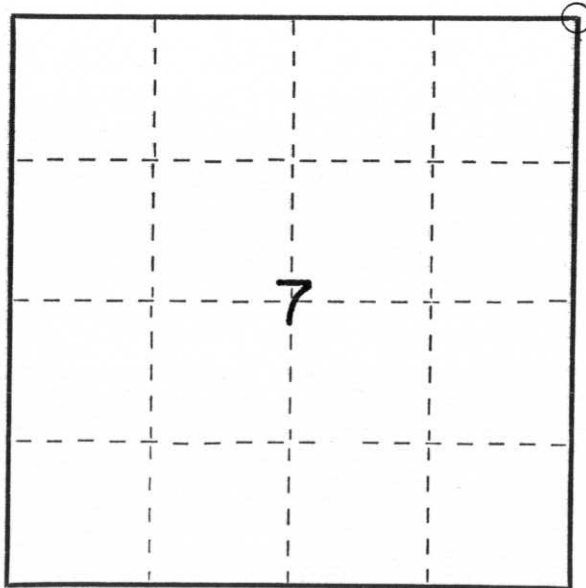

○ = Corner monument restored.

History of original corner establishment:

Original Surveyor: A. G. Ellis and L. G. Ellis
Date of original survey: March, 1852
Original Corner: Wood Post
Original Bearing Trees: Pine 12" S24°E, 8 Lks.
Birch 14" S62°W, 19 Lks.

Description of corner evidence found:

There was no original evidence available. The highway was rebuilt in 1935 and there was no evidence of a monument mentioned on the highway plans. Therefore, I used an existing fence line which ran North and South and I set it 3 feet south of the centerline of State Trunk Highway "17" which was indicated on the 1935 Highway plans.

Description of monument and accessories I established to perpetuate the original location of this corner.

Set a Lincoln County Berntsen monument - 36" - witnessed by
a P.K. nail in Power Pole #3107-8 WI S47°E, 80.6 feet
a P.K. nail in a 14" White Pine N28°W, 100.7 feet
a 1" iron pipe S1°W, 57.0 feet
a Division of Highway monument N8°E, 94.0 feet

Dated at Merrill, Wis., this 10 TH day of JUNE, 1976

Signature Sheridan D. Schwark Title Reg. Land Surveyor Registration No. S-1205
(County Surveyor, Registered Land Surveyor, or other duly authorized official)

Office of Register of Deeds, County of _____, I hereby certify that the within instrument was filed in this office for record on the _____ day of _____, 19____ at _____ o'clock _____ M.

(Register of Deeds)

By _____ Deputy