


May 27, 1970


T31 N, R7E

REFERENCES

116.

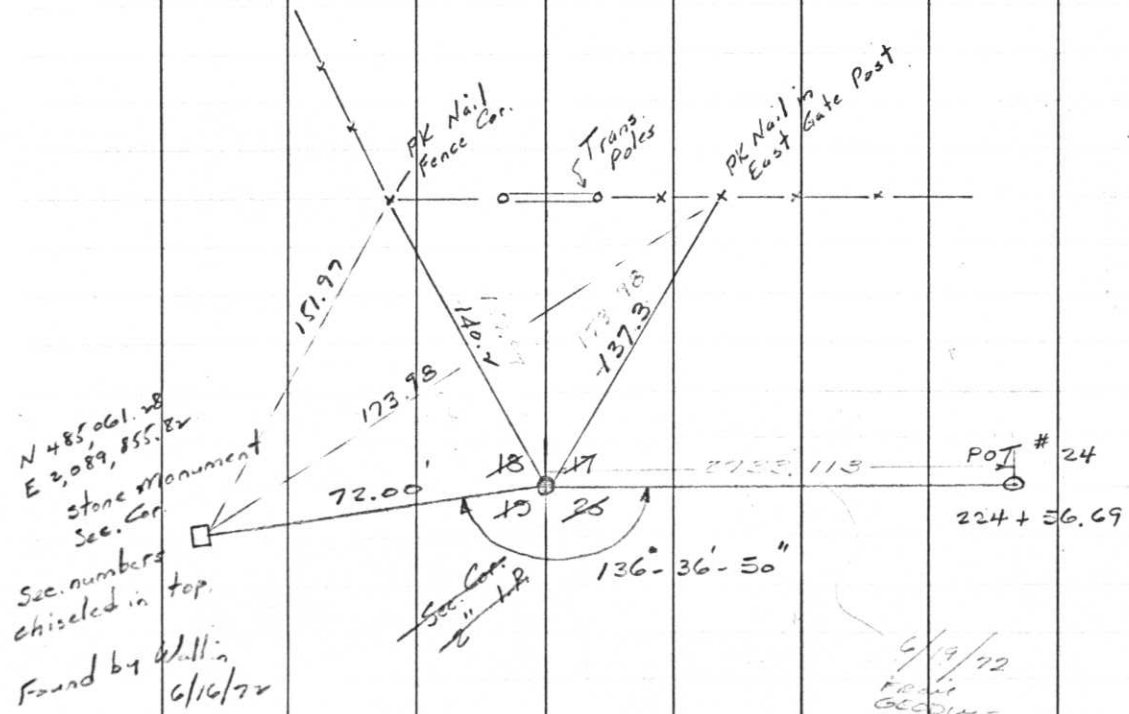

6/19/72
FROM
GEOGRAPHIC
DISTANCES

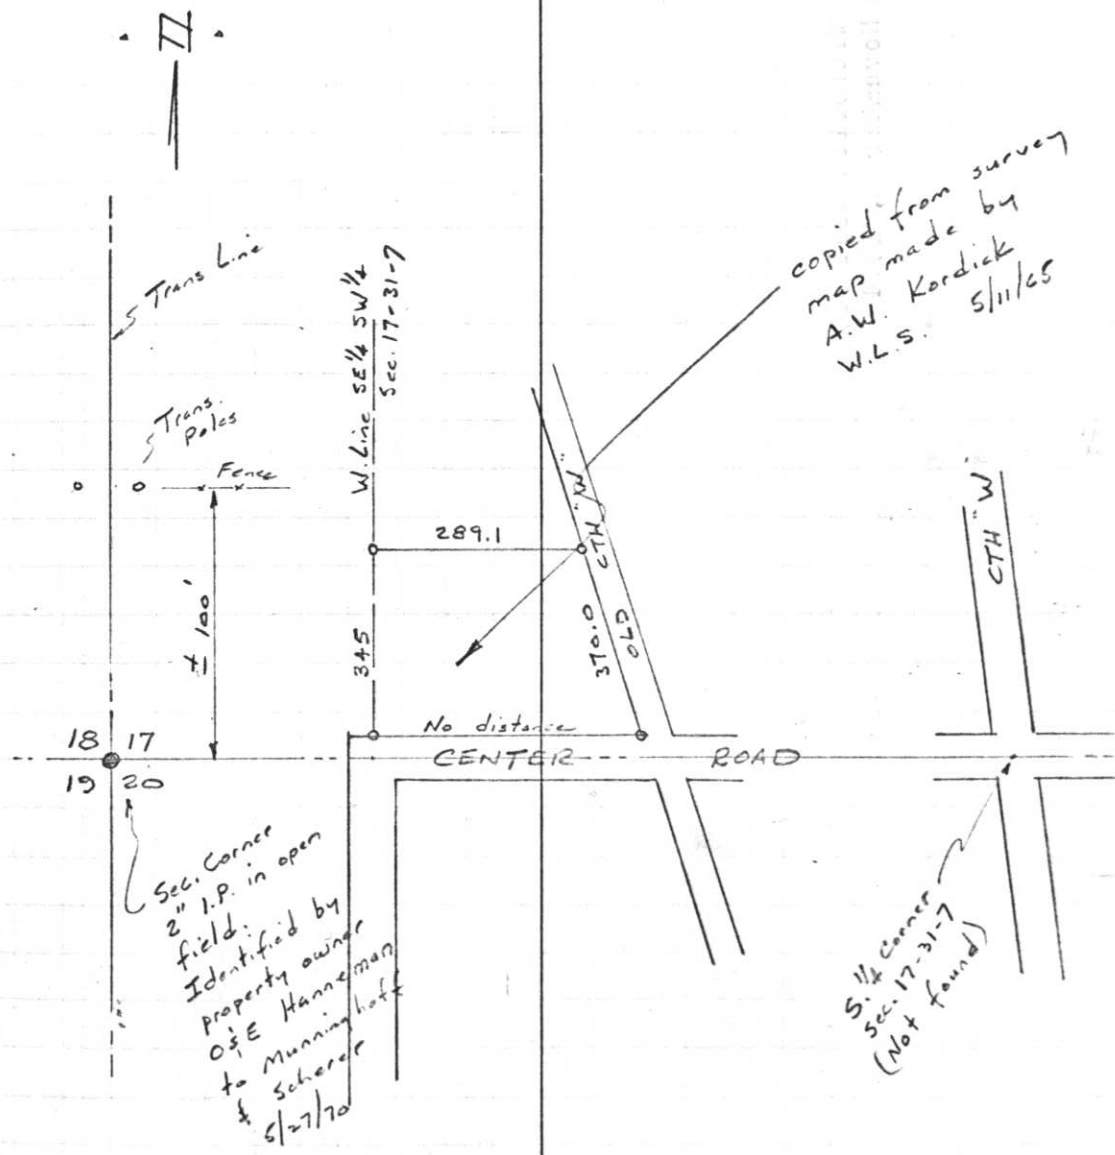

copied from survey
map made by
A.W. Kordick
W.L.S. 5/11/65

Project I.D. 1173-2-00 So. Co. Line
-1.4 Mi. N. Merrill U.S.H. 51
Freeway Lincoln County Wm. Scherer
Surveyor Received from Division of
Hwy's Jan. 11, 1973

U.S. PUBLIC LAND SURVEY MONUMENT RECORD


Note: This form is intended and designed to fulfill all requirements of Wisconsin Administrative Code, Chapter A-E 5.02, U.S. Public Land Survey Monument Record (3)(a)(b)(c)(d)(e)(f)(g)(h)(i). An additional sheet may be added if necessary to conform with said requirements.

(a) Corner location: Township 31 North

Range 7 East

Town/City/Village PINE RIVER


County LINCOLN

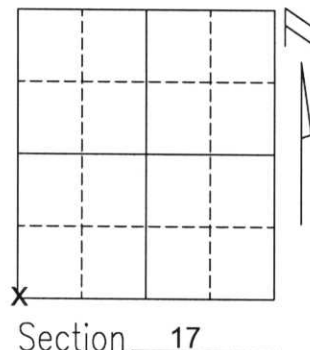

(b)(f)(g)(h) Description of monument found at this corner and if it was accepted, state all evidence (material, testimonial, occupational, plats, records, other monuments) used as a basis for accepting. If not accepted or if nothing was found, state evidence used as basis for establishing location. If reestablished through lost corner proportionate methods, indicate all monuments, distances and directions used to establish.

I found 6"x6" stone as shown on current tie sheet found at Lincoln County Surveyors Office. Several ties were missing or disturbed. The corner was then re-tied.

(c)(d)(e) Plan view of corner with ties to at least 4 witness monuments. If in disagreement with previously established corner, show the distances between the two corners and also indicate the ties to the disputed corner.

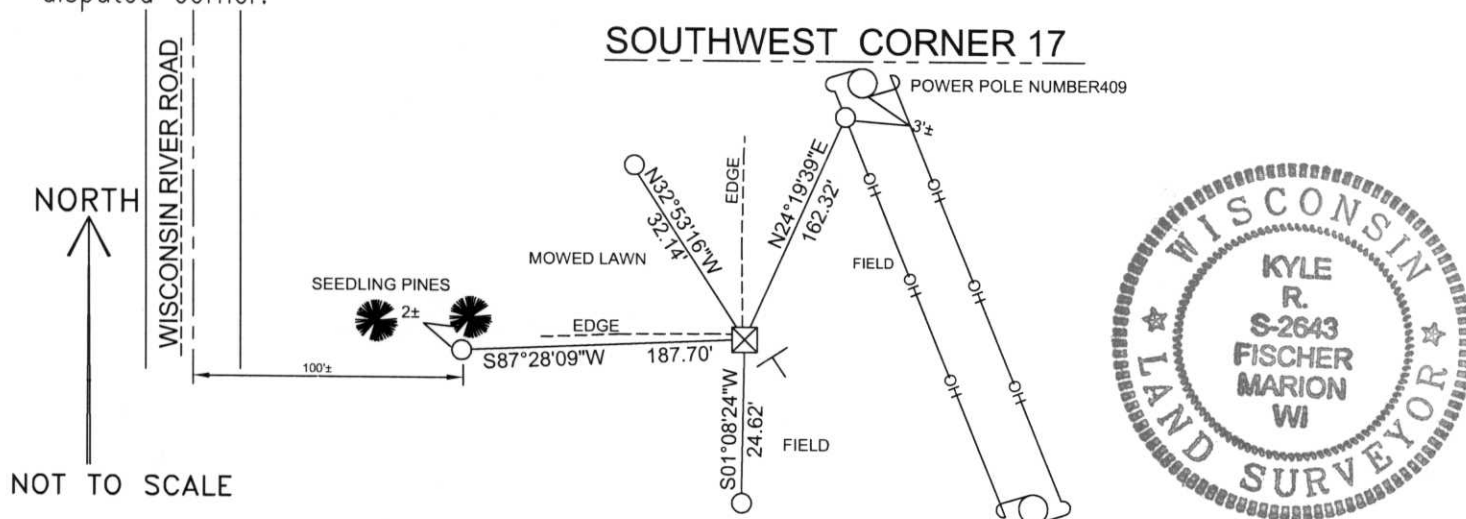

NOT TO SCALE

— FOUND 6"X6" STONE

— SET 3/4"X30" REBAR WITH ALUM. CAP

— SET VINYL TEE POST

NOTE
 ALL BEARINGS SHOWN ARE REFERENCED TO LINCOLN COUNTY COORDINATE SYSTEM.
 ALL TIES MEASURED ELECTRONICALLY WITH TOTAL STATION.

(i) I, Kyle R. Fischer
 (type or print name) certify that the corner location on this record was determined by me or under my direction and control and that this U.S. Public Land Survey Monument Record is correct and complete to the best of my knowledge and belief.

RECEIVED AT LINCOLN COUNTY
 COURTHOUSE THIS 21ST DAY
 OF November 20 03
Zony Galt
 LAND INFORMATION OFFICE

Signature Kyle R. Fischer Date 11-18-03

Index No. M-5