
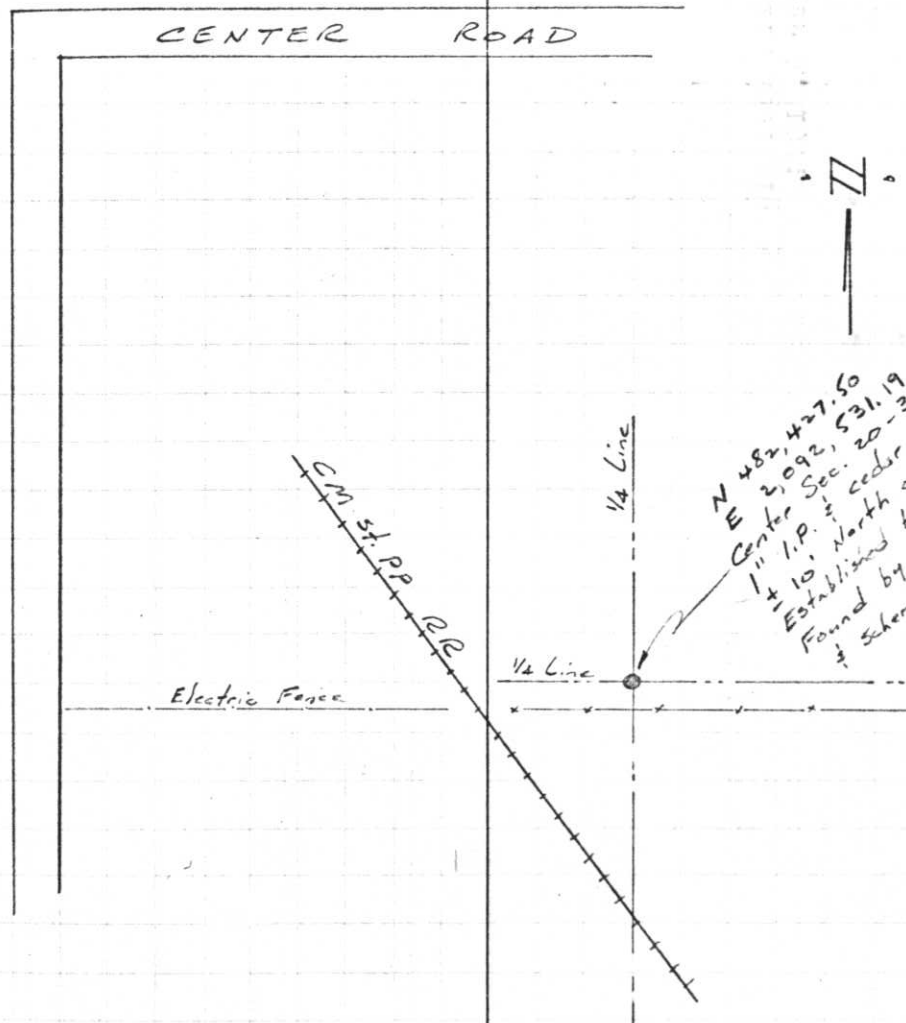


REFERENCES

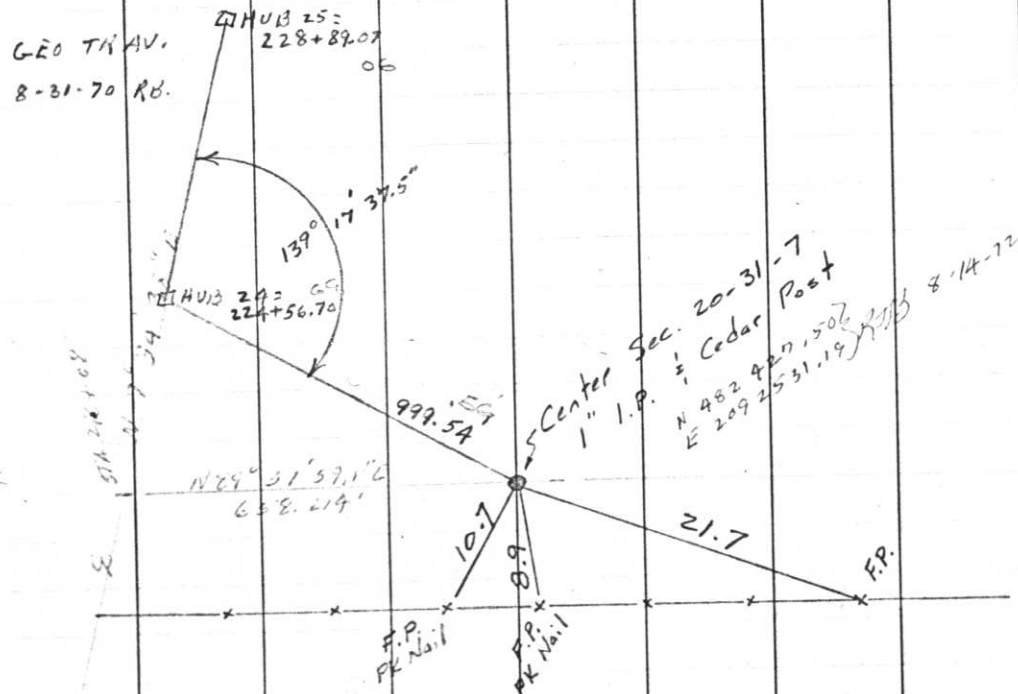

Project I.D. 1173-2-00 So. Co. Line  
 -1.4Mi. N. Merrill U.S.H. 51  
 Freeway Lincoln County Wm. Scherer  
 Surveyor Received from Division of  
 Hwy's Jan. 11. 1973