


121.


FIELD SURVEY NOTES
PRESERVATION OF LANDMARKS
 (Pursuant to Section 59.635(7) Wisconsin Statutes)

Wisconsin Department of Transportation
 E-D-70747


COUNTY LINCOLN		
TOWN PINE RIVER		
HIGHWAY COUNTY TRUNK 'P'		
SECTION 27	TOWNSHIP 31N	RANGE 7E
TYPE OF LANDMARK BRASS CAP SET IN CONC.		

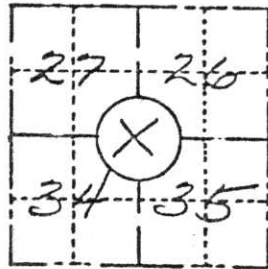

LOCATION SKETCH
 (Location of landmark indicated by "x")

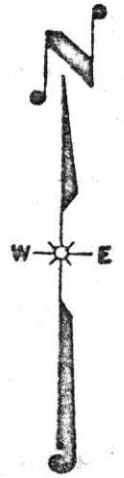

This space for copy of field notes or ties to the above described landmarks

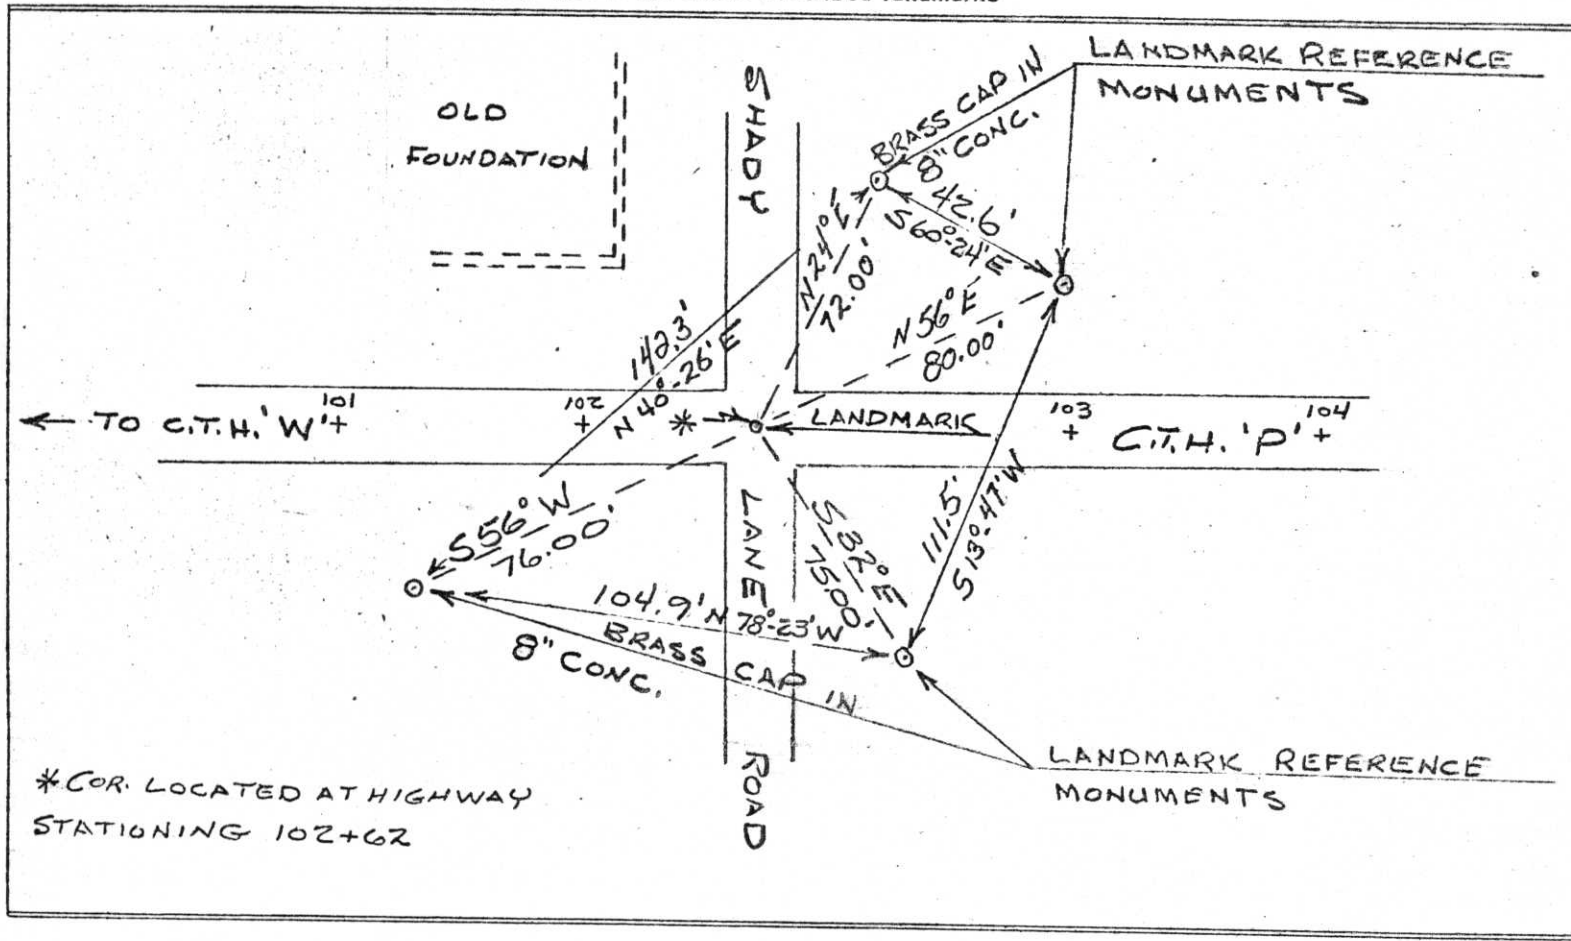

*COR. LOCATED AT HIGHWAY
 STATIONING 102+62

FILED UNDER PROJECT NUMBER 50569(7) 9424-1-70		COUNTY CLERK'S OFFICE COUNTY OF Lincoln WISCONSIN } 55	
SHC DISTRICT OFFICE NUMBER 7	CITY RHINELANDER	COUNTY ONEIDA	DATE RECEIVED FOR RECORD 1/8/74
LOCATED OR ESTABLISHED BY NAME Am. West RCS 066C		DATE COPY SENT TO COUNTY SURVEYOR 1/8/74	
TITLE Dist Const. Engr. DATE 1/2/74		SIGNATURE OF COUNTY CLERK Ken Olden	

RECEIVED
 LINCOLN COUNTY
 FORESTRY TAX DEPARTMENT

4-17