



128.

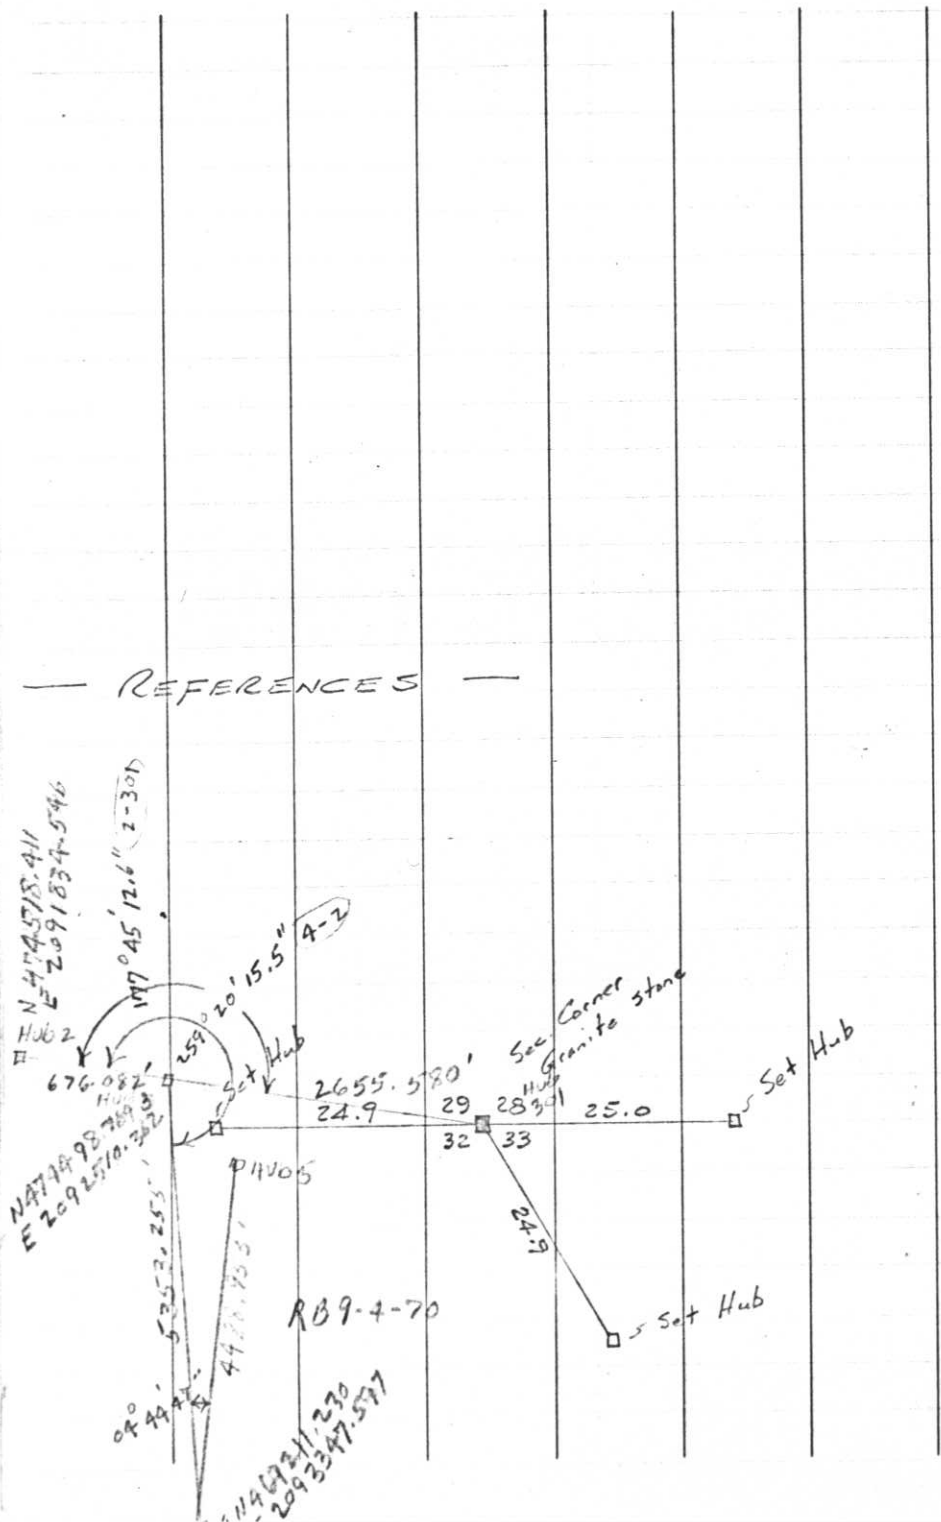

T31N, R7E

June 1, 1970

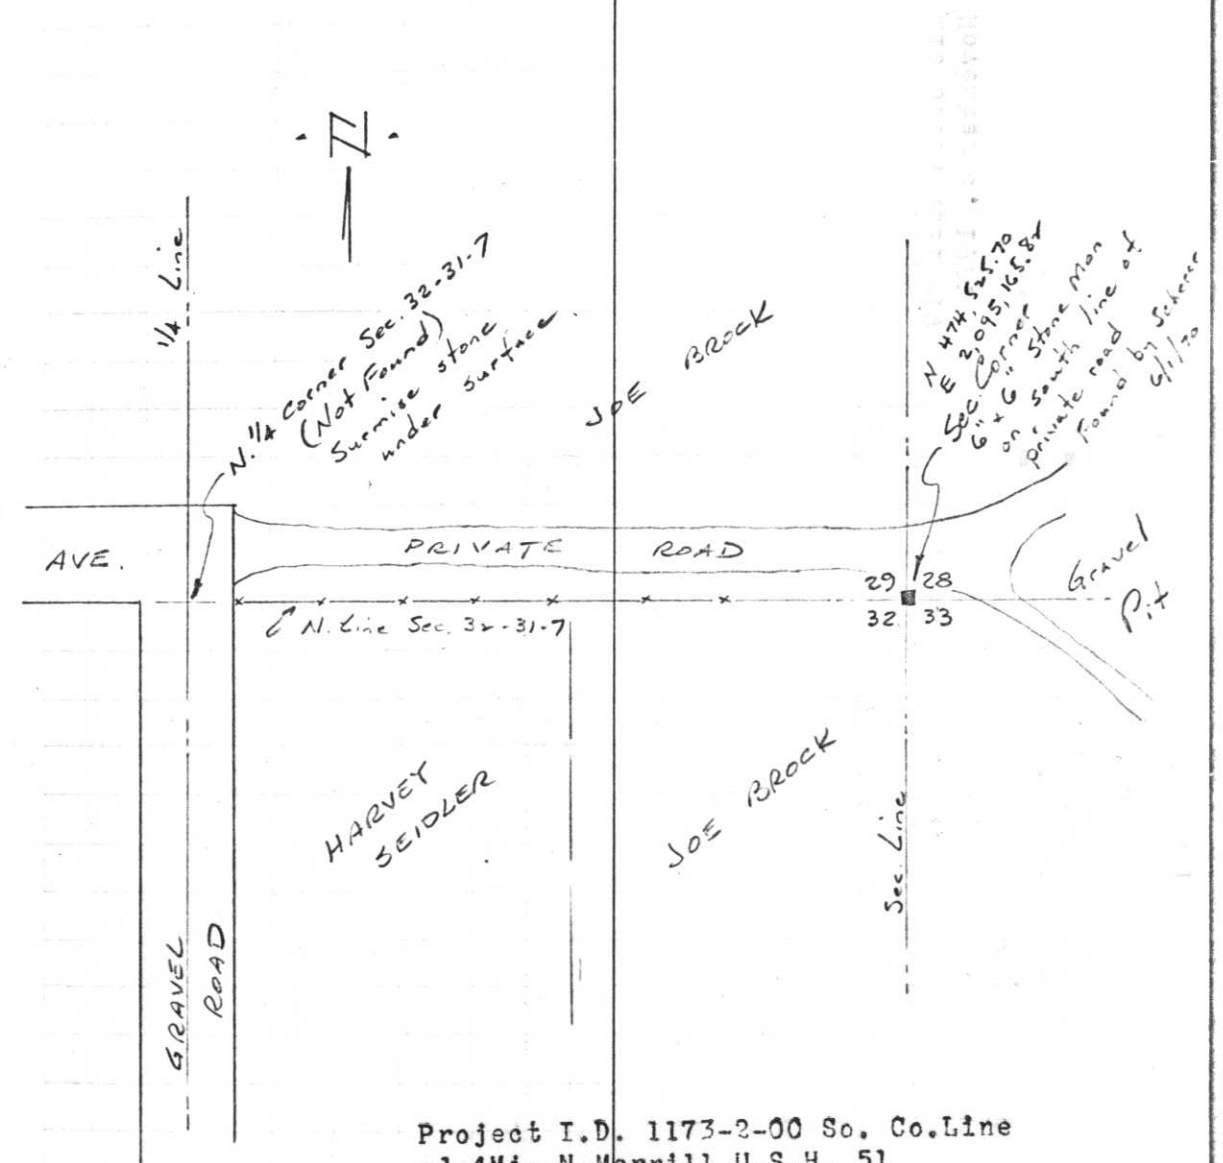

Project I.D. 1173-2-00 So. Co. Line  
 -1.4 Mi. N. Merrill U.S.H. 51  
 Freeway Lincoln County Wm. Scherer  
 Surveyor Received from Division of  
 Hwy's Jan. 11, 1973