

CERTIFIED LAND CORNER RESTORATION

Index No. 4-7

State of Wisconsin }  
County of Lincoln } ss.

History of original corner establishment:

Date: March, 1852  
Surveyor: A.G. & F.S. Ellis  
Monument: Wood Post  
Witnesses: 16" Pine, N7°W, 10 links  
28" Pine, S7°E, 10 links

I Sheridan D. Schwark, do hereby certify that on the 29th day of December, 1977, I found evidence of the South one-quarter corner of Section 29 Township 31, North, Range 7 East, Fourth, Principal Meridian, as described hereon; and that from this evidence I established a new monument and accessories as described hereon to perpetuate the original location of this corner.

Description of corner evidence found:


I set the corner by single proportionate method between granite monuments found at the Southeast and Southwest corners of Section 29. In 1903 a granite monument was set by Louis Kleinschmidt (Land Surveyor). If the stone had been in position before U.S.H. "51" was rebuilt, it would have been destroyed by construction.

Resident witnesses:

.....  
.....  
.....

Description of monument and accessories I established to perpetuate the original location of this corner.

We set a Lincoln County Berntsen Monument having the following witness monuments:  
1 1/4" x 30" solid round iron rod set approximately 1' West of right-of-way fence bearing N15°E, 16.72'  
1 1/4" x 30" solid round iron rod set approximately 1' West of right-of-way fence bearing S4°W, 45.27'  
1 1/4" x 30" solid round iron rod set approximately 5' South of red warning sign and 1' East of end of bituminous bearing S81°W, 33.75'  
1 1/4" x 30" solid round iron rod set approximately 5' North of red warning sign and 3' East of end of bituminous bearing N65°W, 35.40'

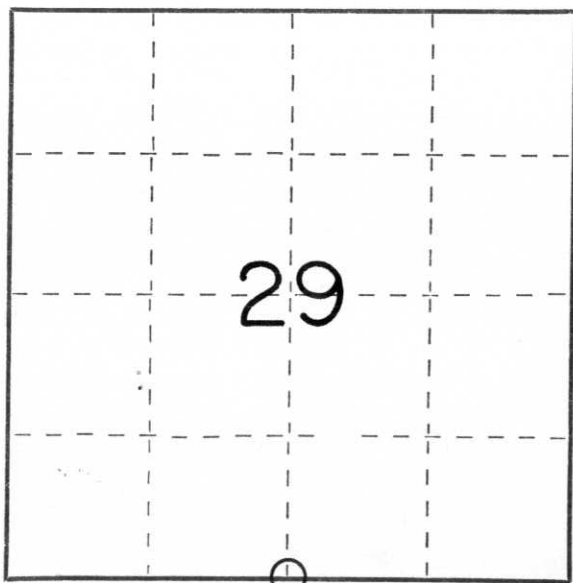

○ = Corner monument restored.

Dated at Merrill, Wis., this 22nd day of June, 1978.

Signature Sheridan D. Schwark Title Registered Land Surveyor Registration No. S-1205  
(County Surveyor, Registered Land Surveyor, or other duly authorized official)

Office of Register of Deeds, County of \_\_\_\_\_, I hereby certify that the within instrument was filed in this office for record on the \_\_\_\_\_ day of \_\_\_\_\_, 19\_\_\_\_ at \_\_\_\_\_ o'clock \_\_\_\_\_ M.

.....  
(Register of Deeds)

By \_\_\_\_\_ Deputy