


CERTIFIED LAND CORNER RESTORATION

Index No. U-5

State of Wisconsin }
County of Lincoln } ss.

I Alan C. Drum, do hereby certify that on the 28th day of December, 19 77, I found evidence of the Southwest corner of Section 29 Township 31, North, Range 7 East, Fourth, Principal Meridian, as described hereon; and that from this evidence I established a new monument and accessories as described hereon to perpetuate the original location of this corner.

Resident witnesses:
.....
.....
.....

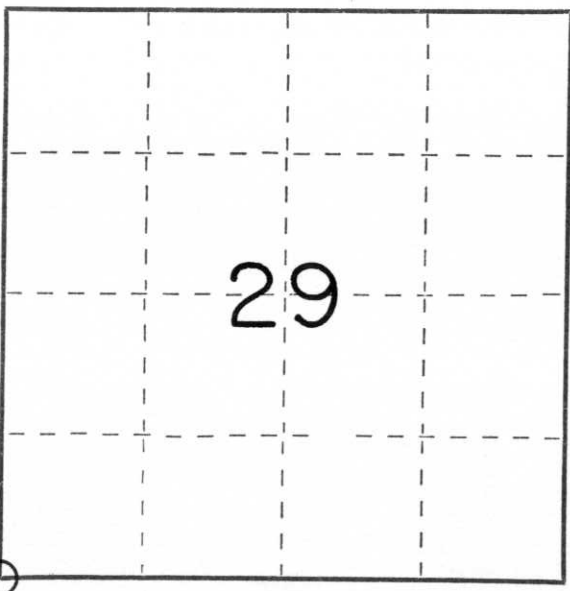

○ = Corner monument restored.

History of original corner establishment:

Date: February & March, 1852
Surveyor: A.G. & F.S. Ellis
Monument: Wood Post
Witnesses: 11" Birch, N86°W, 10 links
10" Hemlock, S51°E, 8 links

Description of corner evidence found:

We excavated the road with a backhoe and found a granite monument approximately 4 feet below the road. It was a monument of the same type we've found in the Town of Scott before, which was set by Louis Kleinschmidt (Land Surveyor) in 1903. There is a map of his resurvey in the Register of Deeds office in the Courthouse.

Description of monument and accessories I established to perpetuate the original location of this corner.

We replaced the stone monument with a Lincoln County Berntsen Monument having the following witness monuments:
1" x 30" iron pipe set 1' westerly of reference point sign bearing N16°E, 32.60'
P.K. set in top of 24" C.M.C.P. (culvert) bearing S27°E, 70.53'
P.K. set in top of 24" C.M.C.P. (culvert) bearing S18°W, 72.43'
1" x 30" iron pipe set 1' westerly of power pole No. 5561 bearing S23°E, 95.77'

Dated at Merrill, Wis., this 22nd day of June, 19 78.

Signature Alan C. Drum Title Registered Land Surveyor Registration No. S-1456
(County Surveyor, Registered Land Surveyor, or other duly authorized official)

Office of Register of Deeds, County of _____, I hereby certify that the within instrument was filed in this office for record on the _____ day of _____, 19 _____ at _____ o'clock _____ M.

.....
(Register of Deeds)

By _____ Deputy