

**MARATHON COUNTY**  
**SURVEY MONUMENT LOCATION RECORD**

SECTION 2  
 TOWNSHIP 30  
 RANGE 7  
 TEXAS  
 (CITY, VILLAGE, TOWN)

11  
 NO.

LANDMARK     BENCHMARK    FOUND   
 CORNER IDENTITY: NE COR SEC. 2-30-7    SET   
 STATE PLANE COORDINATE: N: \_\_\_\_\_    RE-SET   
 ZONE: \_\_\_\_\_ E: \_\_\_\_\_    RE-TIED   
 ELEVATION -(FEET): \_\_\_\_\_ DATUM: \_\_\_\_\_  
 THETA ANGLE: \_\_\_\_\_ WEATHER: \_\_\_\_\_  
 DATE OF SURVEY: SEPT. 16, 1971 TEMPERATURE: 65 °F  
 SURVEY PARTY: ABENDROTH, DENZINE, LOBNER



**BASIS FOR MONUMENT LOCATION:**  
 (DESCRIBE METHOD OF SURVEY AND CORNER AUTHENTICATION)


LOCATED STONE MONUMENT FOR SE COR SEC. 32-31-7 (LINCOLN COUNTY), ACCORDING TO THE ORIGINAL GOV'T. NOTES SET 6" SQ CONC. MON. 1.64 LINKS EAST OF EXISTING COR.    SEAL



(SE 32-31-7)

CERTIFIED CORRECT:  
Edwin R. Abendroth  
 5-798  
 REGISTERED LAND SURVEYOR  
 DATE: SEPT. 21, 1971

**TIE SKETCH:** SHOW MINIMUM OF THREE (3) HORIZONTAL TIE DISTANCES TO FIXED WITNESS MONUMENTS. DESCRIBE ALL MONUMENTS FOUND OR SET. CORRECT ALL DISTANCES SHOWN TO STANDARD TEMPERATURE OF 68° F.

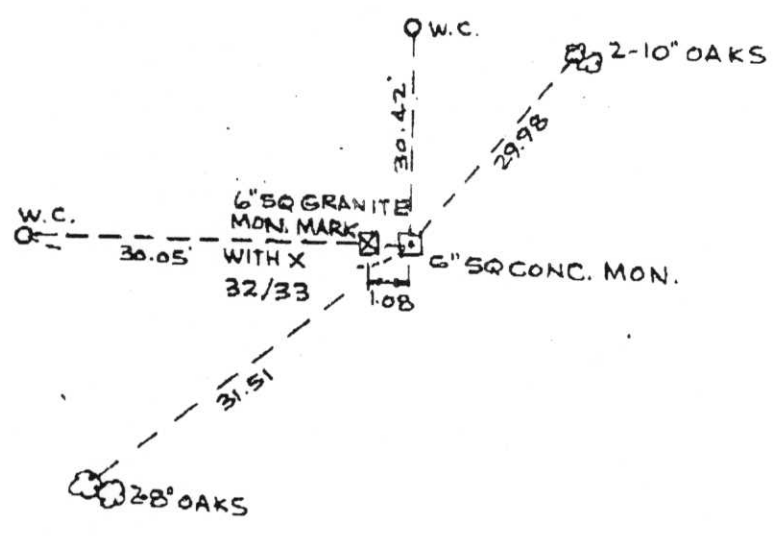

NO. 205 001    MARATHON CITY PLNG ZNG LAND + 9171553660382    15:52    09/29/98

RECEIVED AT LINCOLN COUNTY  
 COURTHOUSE THIS 29 DAY  
 OF Sept 19 98  
 TAX DESCRIPTION OFFICE

6-9