


U.S. PUBLIC LAND SURVEY MONUMENT RECORD

Note: This form is intended and designed to fulfill all requirements of Wisconsin Administrative Code, Chapter A-E 5.02, U.S. Public Land Survey Monument Record (3) (a) (b) (c) (d) (e) (f) (g) (h) (l). An additional sheet may be added if necessary to conform with said requirements.

(a) Corner location: Township 31 North
 Range 7 East
 Town/City/Village PINE RIVER
 County Lincoln

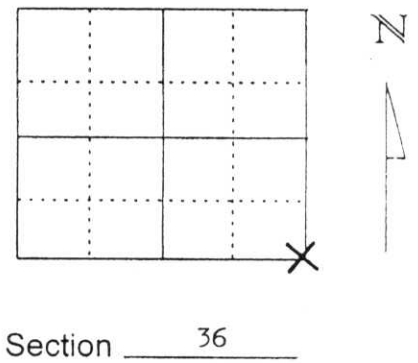

Section 36


(b) (f) (g) (h) Description of monument found at this corner and if it was accepted, state all evidence (material, testimonial, occupational, plats, records, other monuments) used as a basis for accepting. If not accepted or if nothing was found, state evidence used as basis for establishing location. If reestablished through lost corner proportionate methods, indicate all monuments, distances and directions used to establish.

Notes of the original government survey indicate wood posts were set at all Section and Quarter-Section Corners. Stone monuments were subsequently placed at all corners in this area during remonumentation surveys.
 We excavated in blacktop road with Lincoln County Grade-all. Found 6"x 6" Granite Monument with south 1/2 of top chipped. Stone is 1.6 feet below road surface. Set 1" x 18" iron pipe on north side of stone. Accepted stone as correct location of Section corner and tied out as shown below.

RECEIVED AT LINCOLN COUNTY
 COURTHOUSE THIS 24TH DAY
 OF October 20 03
Tom Dalt
 LAND INFORMATION OFFICE



(c) (d) (e) Plan view of corner with ties to at least 4 witness monuments. If in disagreement with previously established corner, show the distances between the two corners and also indicate the ties to the disputed corner.

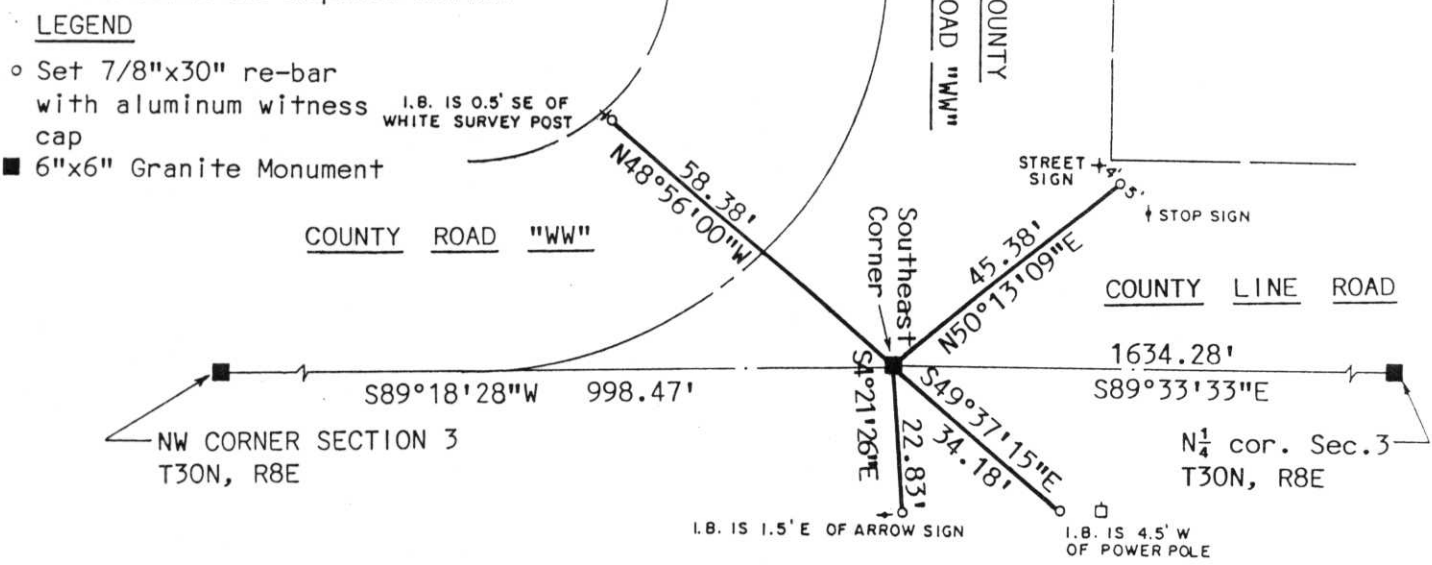

(l) I, David J. Goslin
 (type or print name) certify that the corner location on this record was determined by me or under my direction and control and that this U.S. Public Land Survey Monument Record is correct and complete to the best of my knowledge and belief.
David J. Goslin March 28, 2003
 Signature Date

Index No. 1-25