

CERTIFIED LAND CORNER RESTORATION

Index No. E-25



William F. Kelly

State of Wisconsin }
County of LINCOLN } ss.

I WILLIAM F. KELLY, do hereby certify that on the 5TH day of FEBRUARY, 1975, I found evidence of the SECTION corner of SECTIONS 1, 6, 7, & 12 Township 31, North, Range 9 EAST, Fourth, Principal Meridian, as described hereon; and that from this evidence I established a new monument and accessories as described hereon to perpetuate the original location of this corner.

Resident witnesses:

WALTER KRAUSE



History of original corner establishment:

GRANITE STONE SET IN THE 1920'S

Description of corner evidence found:

LOCATED 6" x 6" GRANITE STONE WITH + ON TOP. ALSO FOUND WITNESS TREES. STONE IS IN A SWAMP AND FROST HAD PUSHED IT INTO AN UNSTABLE POSITION.

Description of monument and accessories I established to perpetuate the original location of this corner.

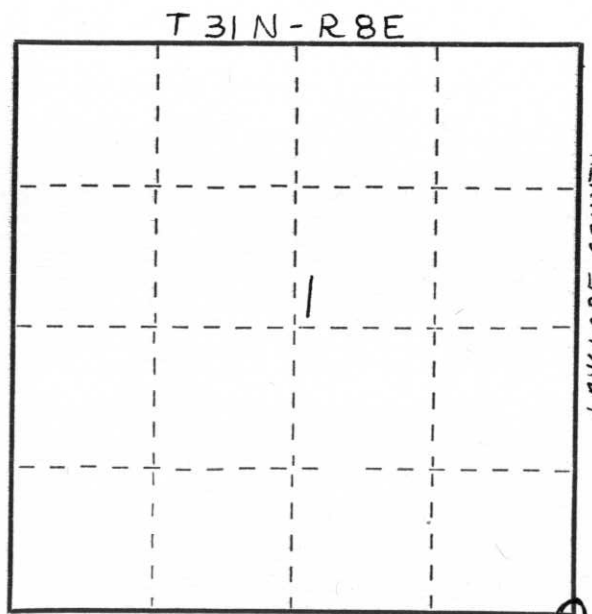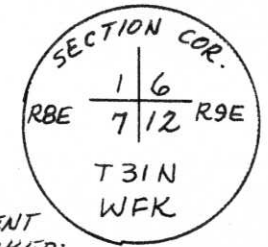

○ = Corner monument restored.

LINCOLN COUNTY

Dated at ELCHO, Wis., this 5TH day of FEBRUARY, 1975

Signature William F. Kelly Title REGISTERED LAND SURVEYOR Registration No. 51098
(County Surveyor, Registered Land Surveyor, or other duly authorized official)

Office of Register of Deeds, County of _____, I hereby certify that the within instrument was filed in this office for record on the _____ day of _____, 19____ at _____ o'clock _____ M.

(Register of Deeds)

By _____ Deputy

Should be SE not 9E
Corrected 3/11/76