



CERTIFIED LAND CORNER RESTORATION

Index No. E-23

State of Wisconsin }  
County of Lincoln } ss.

I Sheridan D. Schwark, do hereby certify that on the 1st day of June, 19 79, I found evidence of the north one-quarter corner of Section 12 Township 31, North, Range 8 East, Fourth, Principal Meridian, as described hereon; and that from this evidence I established a new monument and accessories as described hereon to perpetuate the original location of this corner.

Resident witnesses:

.....  
.....  
.....

History of original corner establishment:

Date: July 1852  
Surveyor: A.G. & F.S. Ellis  
Monument: Wood Post  
Witnesses: No bearing trees


Description of corner evidence found:

We found a 6"x6" red granite monument with its top 3" above grade.

Description of monument and accessories I established to perpetuate the original location of this corner.


□ = 2" IRON PIPE R.I.P. HAS 3"x3" STEEL PLATE WELDED ON TOP.

■ = 6"x6" GRANITE MONUMENT. SET 3/4" x 30" IRON ROD ON N. SIDE

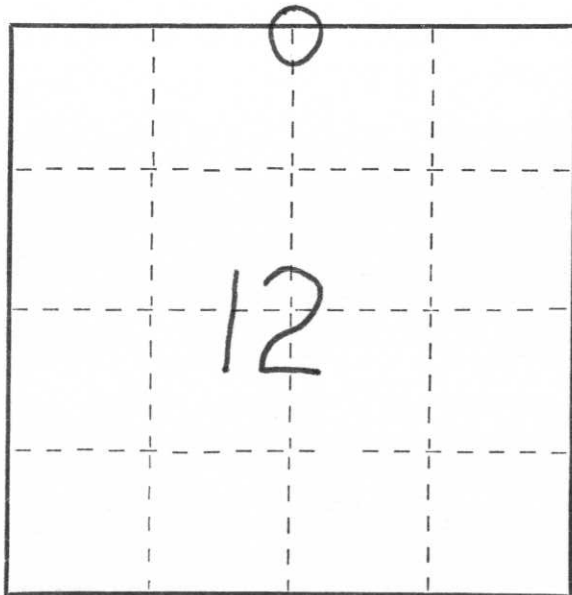

STAMPED AS  
FOLLOWS:

T31N. R8E,  
1/4 S 1  
S 12  
T30N R8E  
R1P10

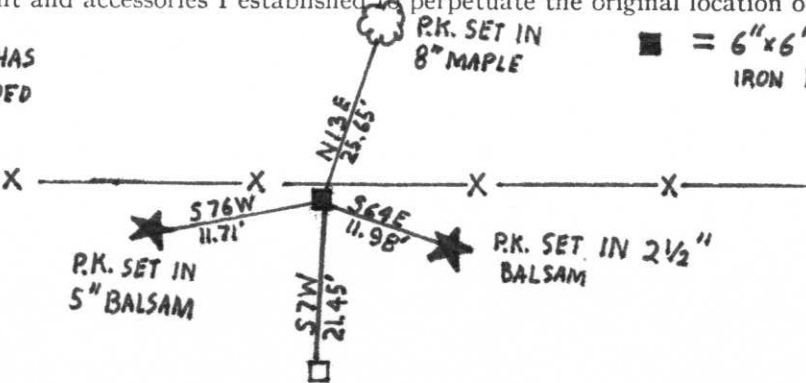

NOTE: ALL BEARING TREES BLAZED

Dated at Wausau, Wis., this 13th day of August, 19 79

Signature Sheridan D. Schwark Title Registered Land Surveyor Registration No. S-1205  
(County Surveyor, Registered Land Surveyor, or other duly authorized official)

Office of Register of Deeds, County of \_\_\_\_\_, I hereby certify that the within instrument was filed in this office for record on the \_\_\_\_\_ day of \_\_\_\_\_, 19 \_\_\_\_\_ at \_\_\_\_\_ o'clock \_\_\_\_\_ M.

(Register of Deeds)

By \_\_\_\_\_ Deputy

○ = Corner monument restored.