

U.S. PUBLIC LAND SURVEY MONUMENT RECORD

NOTE: THIS FORM IS INTENDED AND DESIGNED TO FULFILL ALL REQUIREMENTS OF WISCONSIN ADMINISTRATIVE CODE, CHAPTER A-E 7.08, U.S. PUBLIC LAND SURVEY MONUMENT RECORD (3)(a)(b)(c)(d)(e)(f)(g)(h)(i). ADDITIONAL SHEETS MAY BE NECESSARY TO CONFORM TO SAID REQUIREMENTS.


T 31 N, R 8 E

(a) CORNER LOCATION:

SOUTH QUARTER CORNER, SECTION 3
 TOWNSHIP 31 NORTH
 RANGE 8 EAST
 TOWN OF PINE RIVER
 LINCOLN COUNTY
 WISCONSIN

(b) HISTORY OF ORIGINAL CORNER:

ORIGINAL SURVEYOR: A.G. & F.S. Ellis, Set post
 COMMENCING DATE: February 13, 1852
 COMPLETION DATE: February 25, 1852
 ORIGINAL BEARING TREES:
 7" Hemlock; N 22° W; 29 links
 16" Hemlock; S 28° W; 38 links

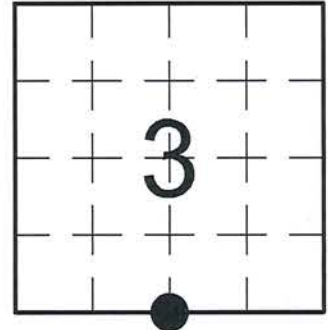

(f)(g)(h) DESCRIPTION OF MONUMENT FOUND AT THIS CORNER AND IF IT WAS ACCEPTED. STATE ALL EVIDENCE (MATERIAL, TESTIMONIAL, OCCUPATIONAL, PLATS, RECORDS, OTHER MONUMENTS) USED AS A BASIS FOR ESTABLISHING LOCATION. IF RE-ESTABLISHING THROUGH LOST CORNER PROPORTIONATE METHODS, INDICATE ALL MONUMENTS, DISTANCES, AND DIRECTIONS USED TO ESTABLISH. INDICATE TYPE OF MONUMENTS FOUND OR SET.


03/02/1962 - N.J.L., Rhinelander Paper Co., notes corner as "Other Accepted Corner" on a Resurvey Map of Section 3, T31N, R8E.

08/11/1981 - A. Drum, RLS-1456, found a 6" x 6" Granite Stone Monument lying on its side. He was able to identify a depression in the ground that remained where the Stone had been and reset the Stone at the location of the depression. He made reference ties to perpetuate the corner location.

03/07/2006 - K. Walkowski, PLS-2717, found a Granite Stone Monument during a remonumentation project for Lincoln County, shown on Lincoln County Surveyor's Office Map No. L423.

12/11/2012 - I, Anthony R. Dallman, PLS-2405, found the 6" x 5" Granite Stone Monument, protruding ±10" above the ground surface, and a 2.5" (o.d.) galvanized Iron Pipe w/ RIPCO cap ±1' west of the Stone. I set new reference ties to further perpetuate the corner location, as shown in the sketch below.

(c)(d)(e) PLAN VIEW OF THE CORNER WITH TIES TO AT LEAST FOUR WITNESSES. IF IN DISAGREEMENT WITH PREVIOUSLY ESTABLISHED CORNER, SHOW THE DISTANCES BETWEEN THE TWO CORNERS AND ALSO THE TIES TO THE DISPUTED CORNER.

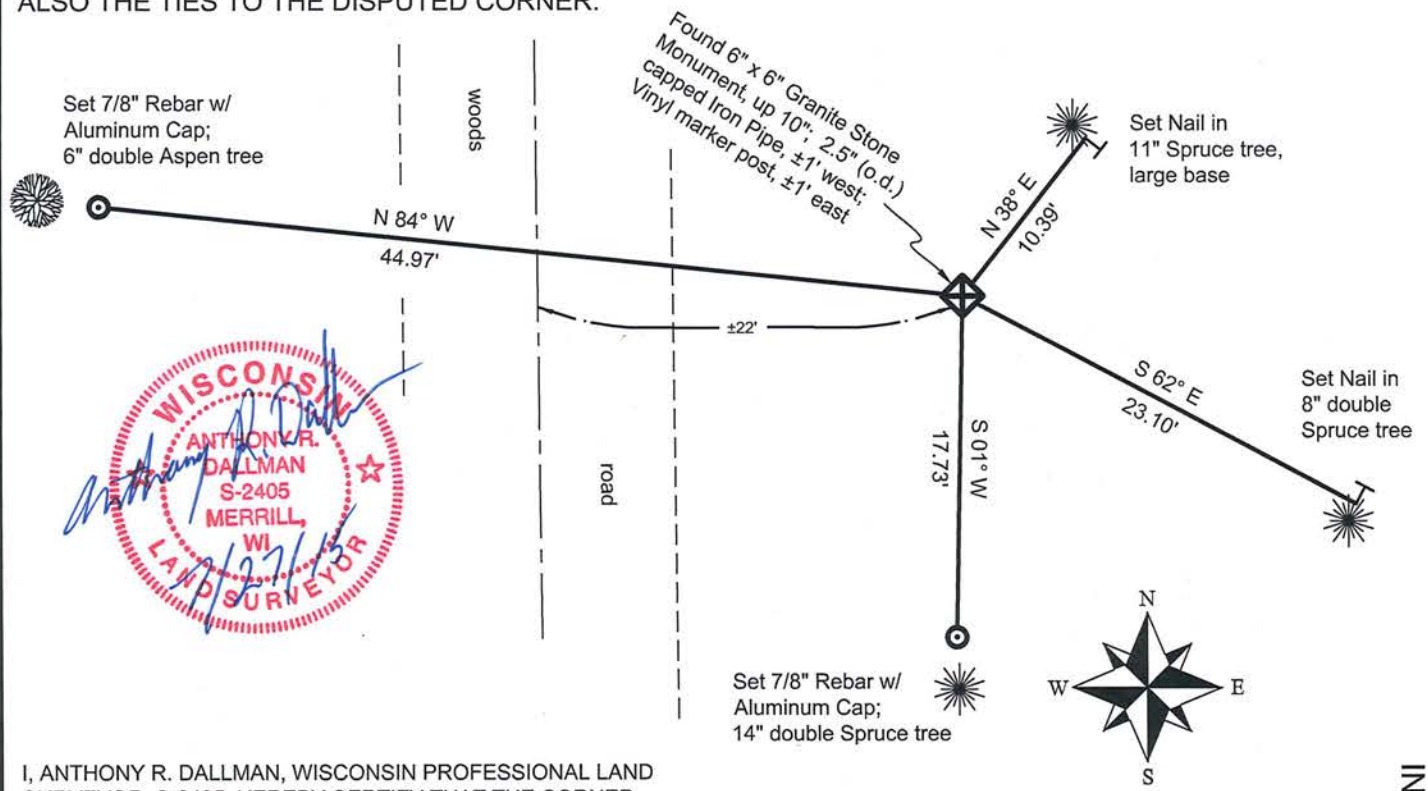

I, ANTHONY R. DALLMAN, WISCONSIN PROFESSIONAL LAND SURVEYOR, S-2405, HEREBY CERTIFY THAT THE CORNER LOCATION ON THIS RECORD WAS REFERENCED BY ME OR UNDER MY DIRECTION AND CONTROL AND THAT THIS U.S. PUBLIC LAND SURVEY MONUMENT RECORD IS COMPLETE TO THE BEST OF MY KNOWLEDGE AND BELIEF.

Anthony R. Dallman 7/27/15
 ANTHONY R. DALLMAN, PLS S-2405

- Bearings by hand-held compass.
 - Distances by steel tape.

INDEX NO. E-15

CERTIFIED LAND CORNER RESTORATION

Index No. E-15


State of Wisconsin }
County of Lincoln } ss.

History of original corner establishment:
Wood post set by Government Surveyor

I Alan C. Drum, do hereby certify that on the 17th day of May, 19 81, I found evidence of the South 1/4 corner of Section 3 Township 31, North, Range 8E, Fourth, Principal Meridian, as described hereon; and that from this evidence I established a new monument and accessories as described hereon to perpetuate the original location of this corner.

Resident witnesses:

.....
.....
.....

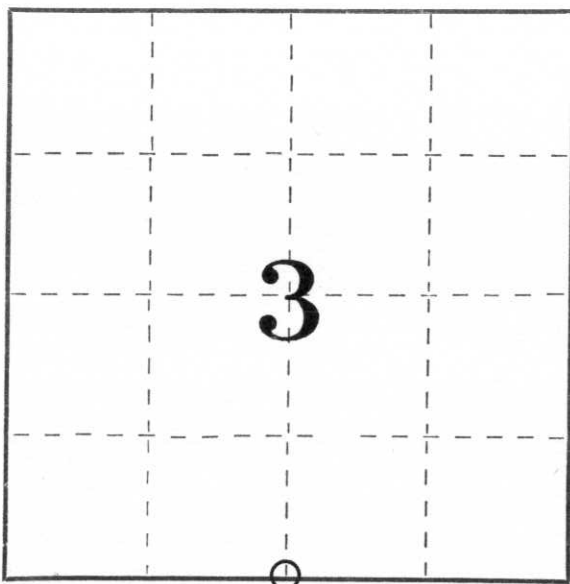


○ = Corner monument restored.

Description of corner evidence found:

6" x 6" granite monument on its side; depression in ground remained where stone had been; redug at location of depression and reset stone. Blazed witness trees and put P.K. Nail in each blaze.

Description of monument and accessories I established to perpetuate the original location of this corner.

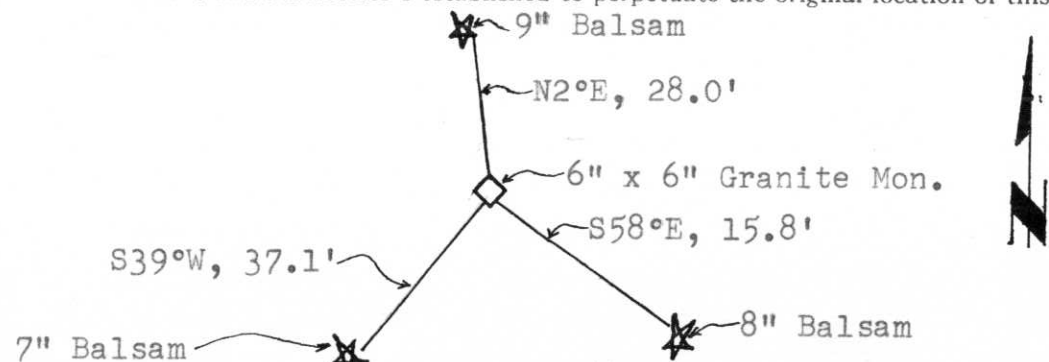

Dated at Merrill, Wis., this 11th day of August, 19 81.

Signature Alan C. Drum Title R.L.S. Registration No. S-1456
(County Surveyor, Registered Land Surveyor, or other duly authorized official)

Office of Register of Deeds, County of Lincoln, I hereby certify that the within instrument was filed in this office for record on the day of 19..... at o'clock M.

.....
(Register of Deeds)

By Deputy