

# U.S. PUBLIC LAND SURVEY MONUMENT RECORD

NOTE: THIS FORM IS INTENDED AND DESIGNED TO FULFILL ALL REQUIREMENTS OF WISCONSIN ADMINISTRATIVE CODE, CHAPTER A-E 7.08, U.S. PUBLIC LAND SURVEY MONUMENT RECORD (3)(a)(b)(c)(d)(e)(f)(g)(h)(i). ADDITIONAL SHEETS MAY BE NECESSARY TO CONFORM TO SAID REQUIREMENTS.


T 31 N, R 8 E

**(a) CORNER LOCATION:**

SOUTHEAST CORNER, SECTION 12  
 TOWNSHIP 31 NORTH  
 RANGE 8 EAST  
 TOWN OF PINE RIVER  
 LINCOLN COUNTY  
 WISCONSIN

**(b) HISTORY OF ORIGINAL CORNER:**

ORIGINAL SURVEYOR: James M. Marsh, Set post  
 COMMENCING DATE: July 8, 1851  
 COMPLETION DATE: July 28, 1851  
 ORIGINAL BEARING TREES:  
 8" Birch; S 50° E; 34 links  
 10" Sugar Maple; S 41° W; 67 links  
 11 Sugar Maple; N 17° E; 67 links  
 18" Birch; N 23° E; 37 links

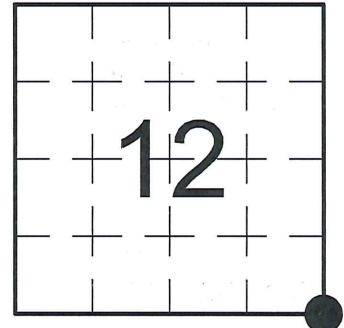

**(f)(g)(h) DESCRIPTION OF MONUMENT FOUND AT THIS CORNER AND IF IT WAS ACCEPTED. STATE ALL EVIDENCE (MATERIAL, TESTIMONIAL, OCCUPATIONAL, PLATS, RECORDS, OTHER MONUMENTS) USED AS A BASIS FOR ESTABLISHING LOCATION. IF RE-ESTABLISHING THROUGH LOST CORNER PROPORTIONATE METHODS, INDICATE ALL MONUMENTS, DISTANCES, AND DIRECTIONS USED TO ESTABLISH. INDICATE TYPE OF MONUMENTS FOUND OR SET.**



02/06/1975 - W. Kelly, RLS-1098, found a 6" x 6" Granite Stone Monument lying on its side. The Stone had been knocked over by logging operation. Resident witness, E. Dittmar, identified the original location of corner and Kelly found a depression in the ground indicating original corner location. He set a Berntsen Aluminum Monument flush with the ground as the corner monument and reset the Stone next to the Aluminum Monument as a witness corner. He made reference ties to perpetuate the corner location.

11/28/2012 - I, Anthony R. Dallman, PLS-2405, found the Berntsen Aluminum Monument (broken) and the 6" x 6" Granite Stone Monument, both tipped. I reset the Granite Stone Monument plumb at the location of the Aluminum Monument base as set by Kelly, down 8" below ground surface with a Rebar along the north edge of the Stone. I set new reference ties to further perpetuate the corner location, as shown in the sketch below.

**(c)(d)(e) PLAN VIEW OF THE CORNER WITH TIES TO AT LEAST FOUR WITNESSES. IF IN DISAGREEMENT WITH PREVIOUSLY ESTABLISHED CORNER, SHOW THE DISTANCES BETWEEN THE TWO CORNERS AND ALSO THE TIES TO THE DISPUTED CORNER.**



- Bearings by hand-held compass.  
 - Distances by steel tape.

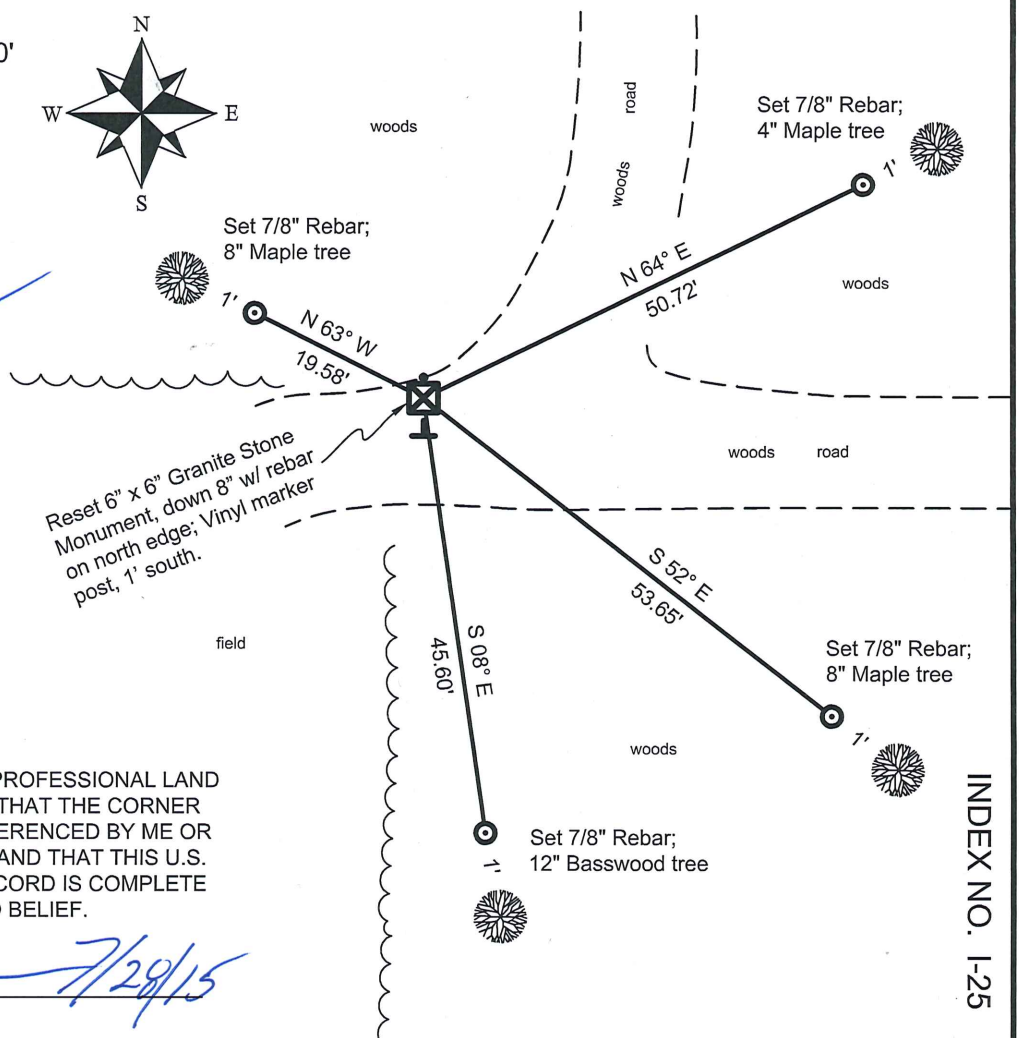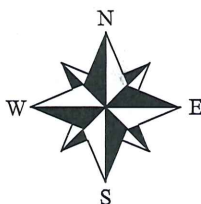

Reset 6" x 6" Granite Stone Monument, down 8" w/ rebar on north edge; Vinyl marker post, 1' south.

I, ANTHONY R. DALLMAN, WISCONSIN PROFESSIONAL LAND SURVEYOR, S-2405, HEREBY CERTIFY THAT THE CORNER LOCATION ON THIS RECORD WAS REFERENCED BY ME OR UNDER MY DIRECTION AND CONTROL AND THAT THIS U.S. PUBLIC LAND SURVEY MONUMENT RECORD IS COMPLETE TO THE BEST OF MY KNOWLEDGE AND BELIEF.

*Anthony R. Dallman* 7/29/15  
 ANTHONY R. DALLMAN, PLS S-2405

INDEX NO. 1-25


CERTIFIED LAND CORNER RESTORATION

Index No. I-25

State of Wisconsin }  
County of LINCOLN } ss.

History of original corner establishment:

GRANITE STONES SET IN THE 1920'S

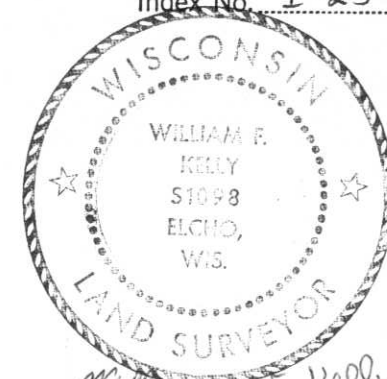

I WILLIAM F. KELLY, do hereby certify that on the 6TH day of FEBRUARY, 1975, I found evidence of the SECTION corner of SECTIONS 12, 7, 13, 18 Township 31, North, Range 8 & 9 EAST, Fourth, Principal Meridian, as described hereon; and that from this evidence I established a new monument and accessories as described hereon to perpetuate the original location of this corner.

Description of corner evidence found:


LOCATED 6x6" GRANITE STONE LYING ON ITS SIDE. STONE HAD BEEN KNOCKED OVER BY LOGGING OPERATION. RESIDENT WITNESS IDENTIFIED ORIGINAL LOCATION OF CORNER. ALSO FOUND DEPRESSION IN GROUND INDICATING ORIGINAL CORNER.

Resident witnesses:


E. DITTMAR

Description of monument and accessories I established to perpetuate the original location of this corner.

SET NEW ALUM. MONUMENT FLUSH WITH GROUND AS CORNER MONUMENT AND RESET STONE NEXT TO MONUMENT AS A WITNESS CORNER.

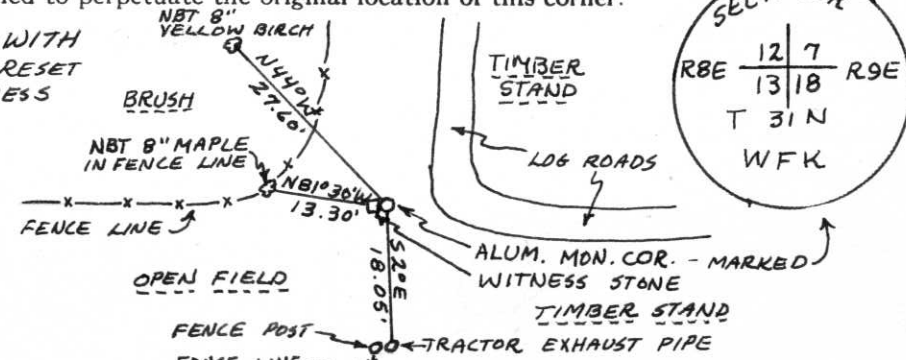

NOTE: NEW BEARING TREES SCRIBED NBT AND MARKED WITH A + AT BASE.

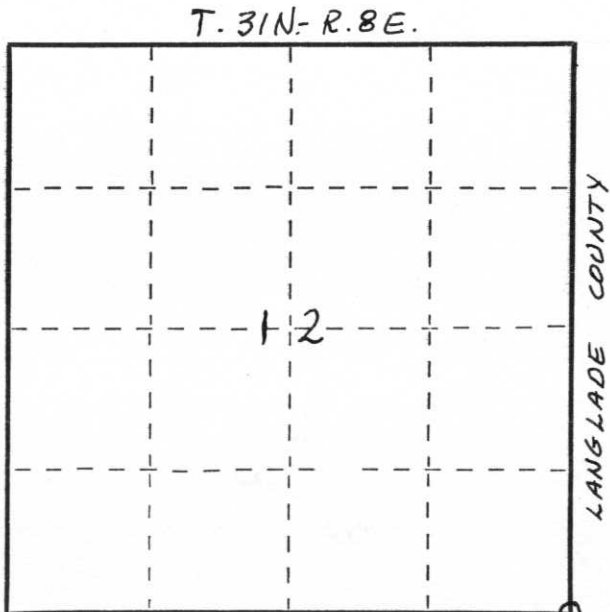

○ = Corner monument restored. COUNTY

Dated at ELCHO, Wis., this 6TH day of FEBRUARY, 1975

Signature William F. Kelly Title REGISTERED LAND SURVEYOR Registration No. 51098  
 (County Surveyor, Registered Land Surveyor, or other duly authorized official)

Office of Register of Deeds, County of \_\_\_\_\_, I hereby certify that the within instrument was filed in this office for record on the \_\_\_\_\_ day of \_\_\_\_\_, 19\_\_\_\_ at \_\_\_\_\_ o'clock \_\_\_\_\_ M.

(Register of Deeds)

By \_\_\_\_\_ Deputy