



CERTIFIED LAND CORNER RESTORATION

Index No. M-23

State of Wisconsin }  
County of Lincoln } ss.


I Alan C. Drum, do hereby certify that on the 2nd day of July, 1979, I found evidence of the north one-quarter corner of Section 24 Township 31, North, Range 8 East, Fourth, Principal Meridian, as described hereon; and that from this evidence I established a new monument and accessories as described hereon to perpetuate the original location of this corner.

Resident witnesses:

.....

.....

.....

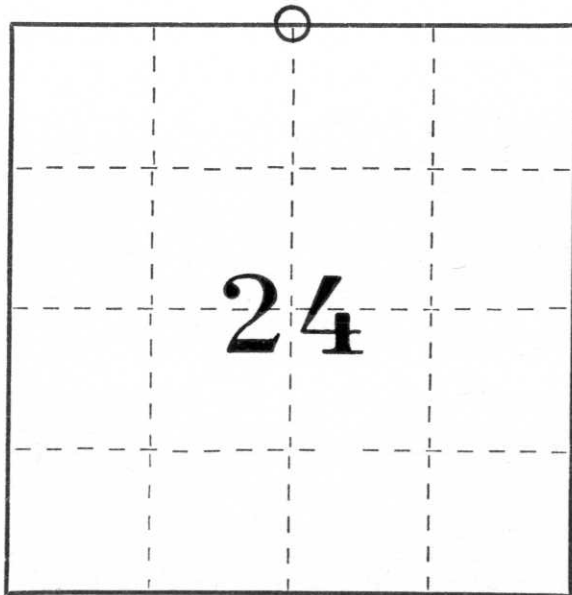

○ = Corner monument restored.


History of original corner establishment:

Date: July 1852  
Surveyor: A.G. & F.S. Ellis  
Monument: Wood Post  
Witnesses: 10" Tamarack S57W 25 links  
7" Fir N51E 23 links

Description of corner evidence found:

After a long search we found a 6x6x30 inch red granite monument buried in mud and lying on its side. It fit the intersection of an old blazed trail from the North and from the East. We reset the stone at its base and it now stands with its top at 0.9 feet above ground level. We also drove wooden stakes along the stone to hold it tighter in the very wet ground. When digging a hole in which to set the stone we found a rotten Cedar stake, pointed, with dimensions 1½x1½x12 inches.

Description of monument and accessories I established to perpetuate the original location of this corner.

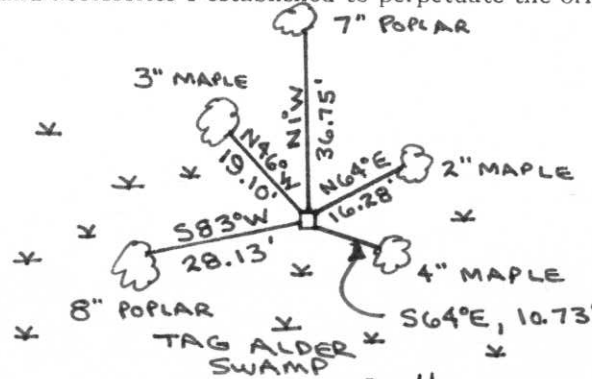

NOTE: ALL BEARING TREES WERE BLAZED AND HAVE SAKES SET IN BLAZES

□ = 6" x 6" GRANITE MONUMENT FOUND. (METAL SPIKE SET ON N. SIDE OF STONE)

Dated at Wausau, Wis., this 30<sup>th</sup> day of July, 1979.

Signature Alan C. Drum Title Registered Land Surveyor Registration No. S-1456  
(County Surveyor, Registered Land Surveyor, or other duly authorized official)

Office of Register of Deeds, County of \_\_\_\_\_, I hereby certify that the within instrument was filed in this office for record on the \_\_\_\_\_ day of \_\_\_\_\_, 19\_\_\_\_ at \_\_\_\_\_ o'clock \_\_\_\_\_ M.

.....  
(Register of Deeds)

By \_\_\_\_\_ Deputy