

MINN CAPITAL SURVEYING, INC.
 SURVEY MONUMENT LOCATION RECORD

LANDMARK BENCHMARK
 CORNER IDENTITY SW COR SEC 17
 DATE OF SURVEY AUG 6, 1974
 WEATHER _____
 TEMPERATURE 80°±
 SURVEY PARTY D.T. + D.M.

FOUND
 SET
 RE-SET
 RE-TIED

SECTION 17
 TOWNSHIP 31
 RANGE 8E
 CITY, VILLAGE, TOWN
LINCOLN COUNTY




BASIS FOR MONUMENT LOCATION
 DESCRIBE METHOD OF SURVEY AND CORNER AUTHENTICATION

FOUND 2" IRON PIPE BURIED 5" BELOW SURFACE.

THE SKETCH SHOW HORIZONTAL TIE DISTANCES TO FIXED WITNESS MONUMENTS. DESCRIBE ALL MONUMENTS FOUND OR SET

NOTE: NAILS & CAP IN FENCE POST
 & TREES.

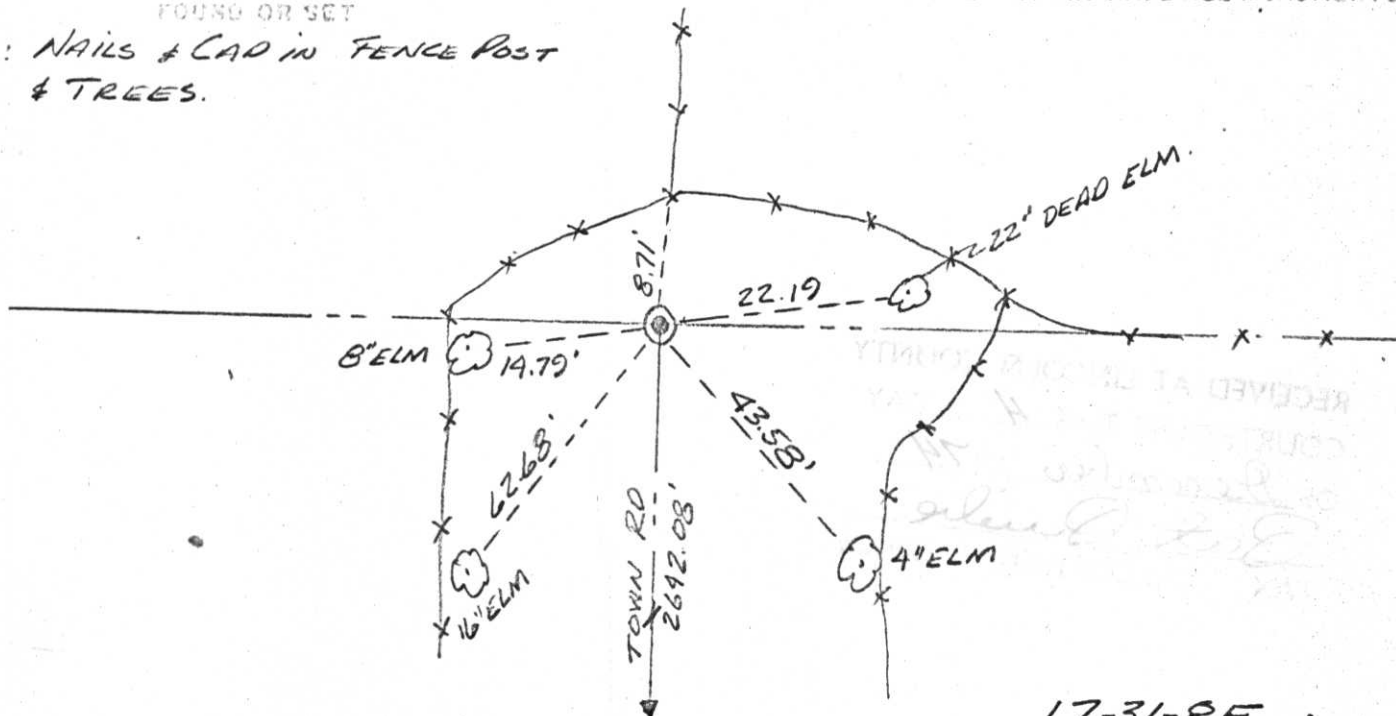

17-31-8E


CERTIFIED LAND CORNER RESTORATION

Index No. m-5

State of Wisconsin }
County of Lincoln } ss.

I Charles Offerman, do hereby certify that on the 8th day of October, 19 82, I found evidence of the Southwest corner of Section 17 Township 31, North, Range 8 East, Fourth, Principal Meridian, as described hereon; and that from this evidence I established a new monument and accessories as described hereon to perpetuate the original location of this corner.

Resident witnesses:

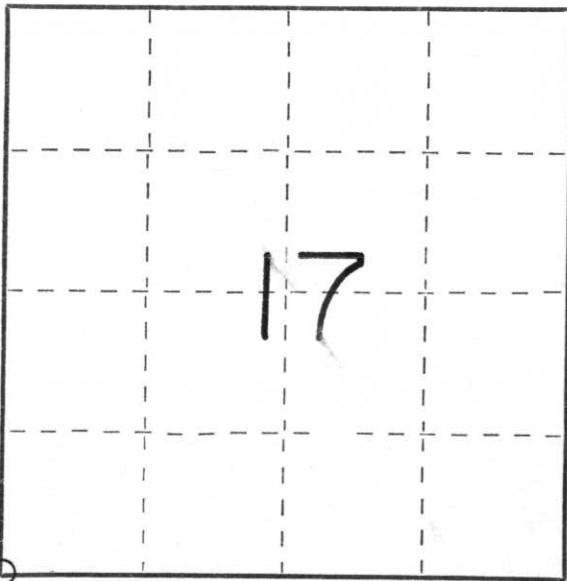

○ = Corner monument restored.


History of original corner establishment:

Set by original government survey.

Description of corner evidence found:

No evidence of the original corner nor it's accessories was found. Found was a 2" Iron Pipe at the intersection of a fence north extended south, a fence east extended west and the centerline of a town road south. This was believed to be the best available evidence and is harmoniously related to existing local conditions. The 2" Iron Pipe was replaced with a standard 30" Bernsten monument.

Description of monument and accessories I established to perpetuate the original location of this corner.

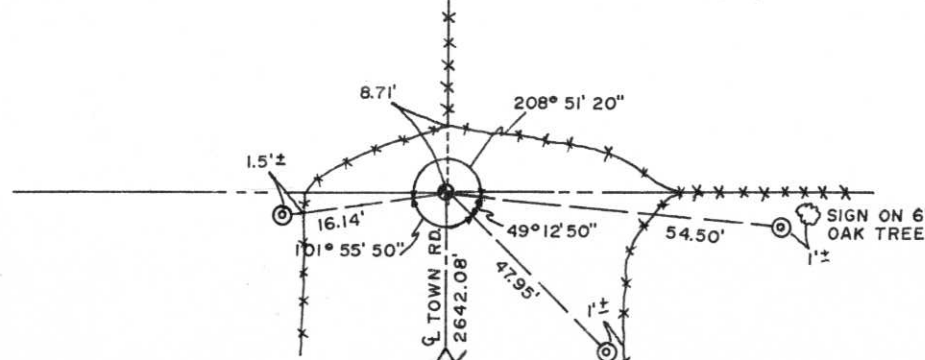

LEGEND

- ⊙ 2" Iron Pipe set for witness monument.
- 30" Bernsten monument
- △ Drag tooth set

Dated at Medford, Wis., this 11th day of October, 19 82

Signature Charles Offerman Title Registered Land Surveyor Registration No. S926
(County Surveyor, Registered Land Surveyor, or other duly authorized official)

Office of Register of Deeds, County of _____, I hereby certify that the within instrument was filed in this office for record on the _____ day of _____, 19 _____ at _____ o'clock _____ M.

(Register of Deeds)

By _____ Deputy