U.S. PUBLIC LAND SURVEY MONUMENT RECORD

Note: This form is intended and designed to fulfill all requirements of Wisconsin Administrative Code, Chapter A-E 5.02, U.S. Public Land Survey Monument Record (3) (a) (b) (c) (d) (e) (f) (g) (h) (l). An additional sheet may be added if necessary to conform with said requirements.


(a) Corner location: Township North	
Range8 East	X 17
Town/City/VillagePINE_RIVER	
County Lincoln	

Section 17

(b) (f) (g) (h) Description of monument found at this corner and if it was accepted, state all evidence (material, testimonial, occupational, plats, records, other monuments) used as a basis for accepting. If not acceptted or if nothing was found, state evidence used as basis for establishing location. If reestablished through lost corner proportionate methods, indicate all monuments, distances and directions used to establish.

ORIGINAL CORNER WAS A WOODEN POST SET IN 1852 BY A.G. & F.L. ELLIS. FOUND 6"x 6" RED GRANITE STONE. RETIED CORNER.

(c) (d) (e) Plan view of corner with ties to at least 4 witness monuments. If in disagreement with previously established corner, show the distances between the two corners and also indicate the ties to the disputed corner.

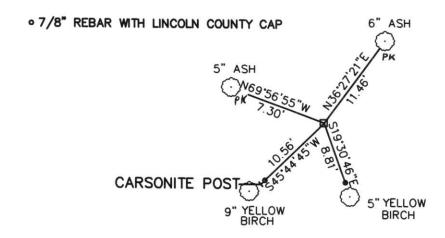

RECEIVED AT LINCOLN COUNTY
COURTHOUSE THIS 19 19 99

Fat Frield
LAND INFORMATION OFFICE

(1	1 (William	W.	Nutter,	RLS,	S-2299

(type or print name) certify that the corner location on this record was determined by me or under my direction and control and that this U.S. Public Land Survey Monument Record is correct and complete to the best of my knowledge and belief.

	3.5	, memorage and bonor
William W. Nutter	5-2299	7-19-99
Signature		Date

ndex No. 人