

CERTIFIED LAND CORNER RESTORATION

Index No. W-5

State of Wisconsin }
County of LINCOLN } ss.

History of original corner establishment:

I LAVERNE H. MOSHER do hereby certify that on the 14TH day of MARCH, 1983, I found evidence of the WEST 1/4 corner of SECTION 32 Township 31, North, Range 8 EAST, Fourth, Principal Meridian, as described hereon; and that from this evidence I established a new monument and accessories as described hereon to perpetuate the original location of this corner.

Original government survey of Section 32, Township 31 North, Range 8 East, conducted in the year of 1852. The original government notes indicate wooden posts were placed to mark section and quarter corners. Date and origin of granite stones set in area are unknown, as the field notes, if any, were destroyed by fire.

Resident witnesses:

Description of corner evidence found:

Excavated with backhoe. At depth of 7 inches below gravel roadway surface, the bottom 24 inches of a 6"x6" Red Granite stone was recovered. Stone was tipped to South, hence was straightened up and a chisel "X" made in center top. A 1"x24" Iron Pipe was placed along North face of stone to aid future location. Stone and pipe are located 6 inches below roadway surface.

Description of monument and accessories I established to perpetuate the original location of this corner.

Monument is 6"x6"x24" Red Granite stone with cross

- NE 98.46' Chisel "X" atop 6' granite boulder
- SE 48.42' Set 1 1/2"x24" Iron Pipe 5' East of telephone riser
- SW 44.98' Spike and Disc on power pole
- NW 27.52' Set 1"x24" Iron Pipe 3' North of fence corner post

(See sketch on reverse)


Dated at Schofield, Wis., this 16th day of March, 1983.

Signature LaVerne H. Mosher Title Reg. Land Surveyor Registration No. S-1188
(County Surveyor, Registered Land Surveyor, or other duly authorized official)

Office of Register of Deeds, County of _____, I hereby certify that the within instrument was filed in this office for record on the _____ day of _____, 19____ at _____ o'clock _____ M.

(Register of Deeds)

By _____ Deputy

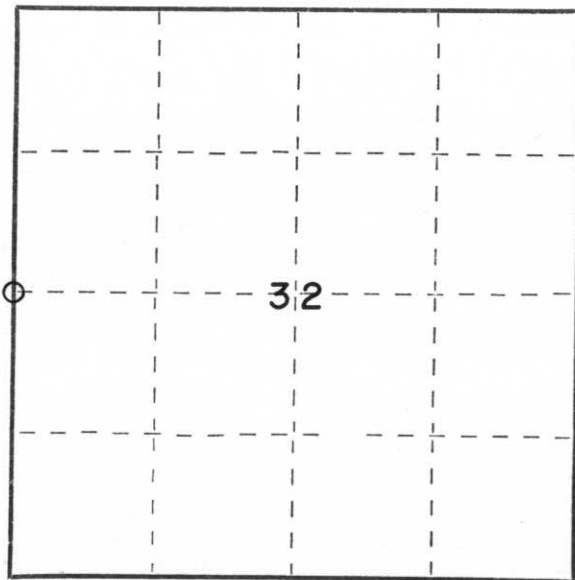

○ = Corner monument restored.



RECEIVED AT LINCOLN COUNTY
COURTHOUSE THIS 24th DAY
OF March 1923.

Dot Miele
TAX DESCRIPTION OFFICE

