


CERTIFIED LAND CORNER RESTORATION

Index No. Y-7

State of Wisconsin }  
County of LINCOLN } ss.

I LAVERNE H. MOSHER, do hereby certify that on the 16<sup>TH</sup> day of MARCH, 1983, I found evidence of the SOUTH 1/4 corner of SECTION 32 Township 31, North, Range 8 EAST, Fourth, Principal Meridian, as described hereon; and that from this evidence I established a new monument and accessories as described hereon to perpetuate the original location of this corner.

Resident witnesses:  
Mr. Walter Young

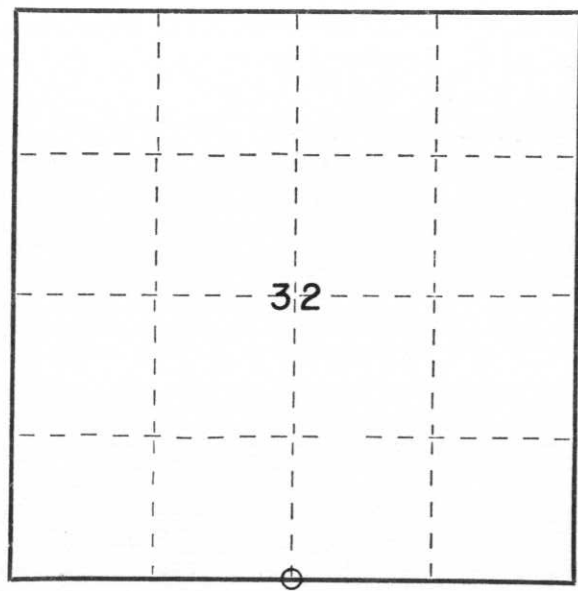

○ = Corner monument restored.

History of original corner establishment:

Original government survey conducted in year of 1852-53 with wooden posts set for section and quarter corners. Subsequently, 6"x6"x36" red granite stone monuments were set during a remonumentation survey of later date (year unknown).

AFFADAVIT: I, Chester Nowaczyk, Registered Land Surveyor #S-1143, do hereby certify that on June 20, 1980, I excavated with a backhoe for this cornerstone and found no evidence of same.

Description of corner evidence found: Longtime area resident Mr. Walter Young informed me that cornerstone had been removed during road construction about 3 years ago and had not been replaced. This testimony was confirmed by Mr. Chester Nowaczyk, Marathon County Surveyor, who said that he had excavated with backhoe for this cornerstone and had found no evidence of corner. A 6"x6"x14" red granite stone with drill hole on side was discovered lying in fence line to North of corner. Mr. Young pointed out location of cornerstone before destruction and a RR spike was set at this point. A traverse of Section 32-31-8 and the North lines of Section 2 & 3, T30N, R8E, indicate that this location was in conformity with lines of occupation and record distances of U.S. government survey, hence was accepted as correct corner location. Description of monument and accessories I established to perpetuate the original location of this corner.

Monument is a RR spike set in blacktop roadway

- North 46.34' Spike and disk in 6" brace post of fence
- ESE 96.63' Set 1"x24" iron pipe 6" North of fence corner post
- WSW 208.78' Spike and disk in power pole

(See sketch on reverse)



Dated at Schofield, Wis., this 18<sup>th</sup> day of March, 1983.

Signature Laverne H. Mosher Title Reg. Land Surveyor Registration No. S-1188  
(County Surveyor, Registered Land Surveyor, or other duly authorized official)

Office of Register of Deeds, County of \_\_\_\_\_, I hereby certify that the within instrument was filed in this office for record on the \_\_\_\_\_ day of \_\_\_\_\_, 19\_\_\_\_ at \_\_\_\_\_ o'clock \_\_\_\_\_ M.

\_\_\_\_\_  
(Register of Deeds)

By \_\_\_\_\_ Deputy

RECEIVED AT LINCOLN COUNTY  
COURTHOUSE THIS 24th DAY  
OF March 1983  
Pat Priebe  
TAX DESCRIPTION OFFICE

