

LINCOLN COUNTY U.S. PUBLIC LAND TIE SHEET RECORD

SECTION 16
TOWNSHIP 32N
RANGE 4 E

163241
NO.

LANDMARK

CORNING
CITY, VILLAGE, TOWN

CORNER INDENTITY: BERNSTEN MONUMENT


LINCOLN COUNTY COORDINATE: N: 154058.7890

E: 311394.0920

DATE OF SURVEY: JUNE 11, 2007

SURVEY PARTY: Rutzen/Nieds

- FOUND
- SET
- RE-SET
- RE-TIED

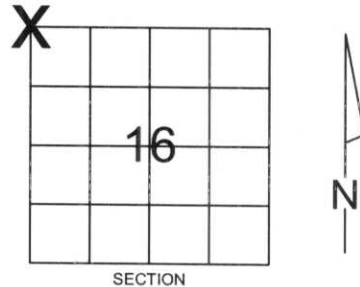

Description of monument found at this corner and if was accepted, state all evidence (material, testimonial, occupational, plats, records, other monuments) used as a basis for accepting. If not accepted or if nothing was found, state evidence used as basis for establishing location. If reestablished through lost corner proportionate methods, indicate all monuments, distances and directions used to establish.

BASIS FOR MONUMENT LOCATION:

(DESCRIBE METHOD OF SURVEY AND CORNER AUTHENTICATION)

Found 3/4" Iron Pipe at corner. Property evidence, bearing tree remains, comparison to original notes, and improvements to Tower Road supported the location of the Iron Pipe as the corner. Lincoln County Bernsten Monument was set to replace the Iron Rod.



CERTIFIED CORRECT:

Ronald Jacobson
Ronald Jacobson RLS 2059-008

Registered Land Surveyor

DATE: June 22, 2007

COMPANY: Central Wisconsin Engineers & Architects
5707 Schofield Ave.
Weston, Wisconsin 54476
(715) 359-9400

TIE SKETCH:

SHOW MINIMUM OF FOUR (4) HORIZONTAL TIE DISTANCES TO FIXED WITNESS MONUMENTS.
DESCRIBE ALL MONUMENTS FOUND OR SET. ALL DISTANCES SHOWN IN US SURVEY FEET.

