

LINCOLN COUNTY U.S. PUBLIC LAND TIE SHEET RECORD

SECTION 19
TOWNSHIP 32N
RANGE 4 E

193245
NO.

LANDMARK


CORNING
CITY, VILLAGE, TOWN

CORNER INDENTITY: 1" IRON PIPE W/ WOOD POST

LINCOLN COUNTY COORDINATE: N: 146029.461
E: 305859.137

DATE OF SURVEY: September 11, 2007
SURVEY PARTY: Dahlvig/Eron

FOUND
SET
RE-SET
RE-TIED

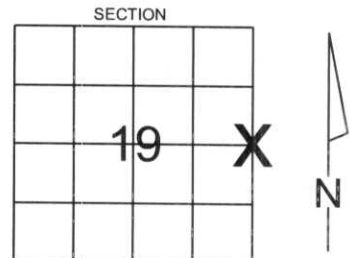

Description of monument found at this corner and if was accepted, state all evidence (material, testimonial, occupational, plats, records, other monuments) used as a basis for accepting. If not accepted or if nothing was found, state evidence used as basis for establishing location. If reestablished through lost corner proportionate methods, indicate all monuments, distances and directions used to establish.

BASIS FOR MONUMENT LOCATION:

(DESCRIBE METHOD OF SURVEY AND CORNER AUTHENTICATION)

Found 1" iron pipe and wood post at corner. Property evidence, and comparison to original notes supports the iron pipe and post as the corner.



RECEIVED BY LINCOLN COUNTY
SURVEYOR THIS 25TH DAY
OF September 20, 07
Tracy Dahl
COUNTY SURVEYOR

CERTIFIED CORRECT:


Ronald Jacobson
Ronald Jacobson RLS 2059-008
Registered Land Surveyor

COMPANY: Central Wisconsin Engineers & Architects
5707 Schofield Ave.
Weston, Wisconsin 54476
(715) 359-9400

DATE: September 20, 2007

TIE SKETCH:

SHOW MINIMUM OF FOUR (4) HORIZONTAL TIE DISTANCES TO FIXED WITNESS MONUMENTS.
DESCRIBE ALL MONUMENTS FOUND OR SET. ALL DISTANCES SHOWN IN US SURVEY FEET.

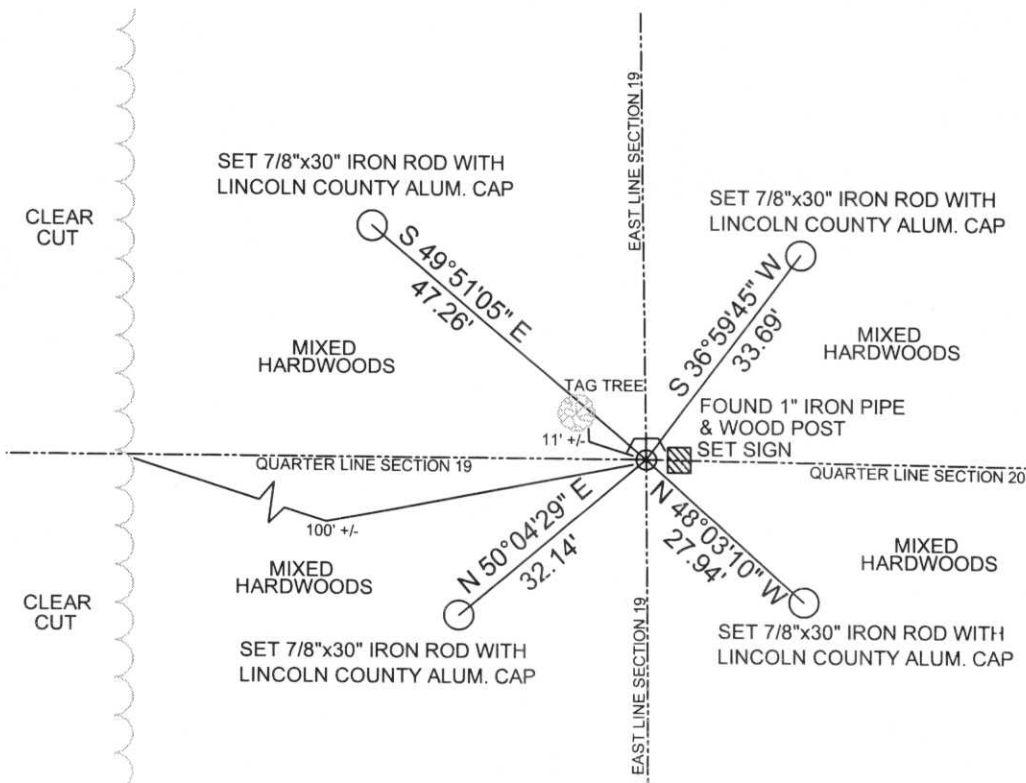

COORDINATES ARE REFERENCED TO LINCOLN COUNTY COORDINATE SYSTEM AS DEVELOPED BY THE WI. DEPARTMENT OF TRANSPORTATION AND ARE BASED ON GPS OBSERVATIONS TO CONTROL POINTS AS SUPPLIED BY LINCOLN COUNTY.

NOT TO SCALE
BEARINGS REFERENCED TO THE LINCOLN COUNTY COORDINATE SYSTEM









