

CERTIFIED LAND CORNER RESTORATION


Index No. E-21

State of Wisconsin }
County of Lincoln } ss.

I Sheridan D. Schwark, do hereby certify that on the 18th day of April, 1978, I found evidence of the Northeast corner of Section 11 Township 32, North, Range 5 East, Fourth, Principal Meridian, as described hereon; and that from this evidence I established a new monument and accessories as described hereon to perpetuate the original location of this corner.

Resident witnesses:

.....
.....
.....

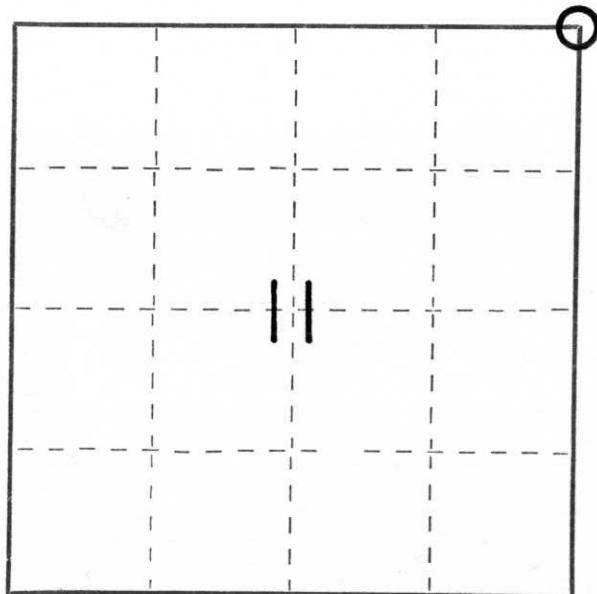

○ = Corner monument restored.

History of original corner establishment:

Date: November, 1852
Surveyor: Rick Chaney
Monument: Wood post
Witnesses: 15" Hemlock N55°30'W 19 links
7" Birch S81° E 31 links

Description of corner evidence found:

A 1 1/2" iron pipe with a 3" x 3" steel plate on top stamped T32N R5E S2, S1, S12, S11, R1PC0 was found. We called Norm Loftus of St. Regis Paper Co., previously called R.I.P.C.O. He said the corner was set in 1959 by proportion.

Description of monument and accessories I established to perpetuate the original location of this corner.

We set the following witness monuments to the monument described above:

- 5" White Birch N86°W, 27.54'
- 6" White Birch S3°W, 20.16'
- 4" White Birch N76°E, 16.35'
- 4" White Birch S58°E, 20.38'

Dated at Merrill, Wis., this 20th day of April, 1978.

Signature Sheridan D. Schwark Title Registered Land Surveyor Registration No. S-1205
(County Surveyor, Registered Land Surveyor, or other duly authorized official)

Office of Register of Deeds, County of _____, I hereby certify that the within instrument was filed in this office for record on the _____ day of _____, 19____ at _____ o'clock _____ M.

(Register of Deeds)

By _____ Deputy