U.S. PUBLIC LAND SURVEY MONUMENT RECORD


NOTE: THIS FORM IS INTENDED AND DESI LAND SURVEY MONUMENT RECORD (3) (a) WITH SAID REQUIREMENTS.	GNED TO FULFILL ALL REQUIREMENTS (b) (c) (d) (0) (f) (g) (h) (i).	OF WISCONSIN ADMINISTRATIVE (AN ADDITIONAL SHEET MAY BE AL	ODE, CHAPTER	A-E 7.08 U.S. PUBLIC ARY TO CONFORM
(a) CORNER LOCATION:	TOWNSHIP 32	NORTH		
	RANGE 5	_EAST/ WEST		
TOWN/CITY/VILLAGE HARDING		# P		/
COUNTY LINCOLN				

(b) (f) (g) (h) DESCRIPTION OF MONUMENT FOUND AT THIS CORNER AND IF IT WAS ACCEPTED, STATE ALL EVIDENCE (MATERIAL, TESTIMONIAL, OCCUPATIONAL, PLATS, RECORDS, OTHER MONUMENTS) USED AS BASIS FOR ACCEPTING. IF NOT ACCEPTED OR IF NOTHING WAS FOUND, STATE EVIDENCE USED AS BASIS FOR ESTABLISHING LOCATION. IF REESTABLISHED THROUGH LOST CORNER PROPORTIONATE METHODS, INDICATE ALL MONUMENTS, DISTANCES AND DIRECTIONS USED TO ESTABLISH. INDICATE TYPE OF MONUMENT FOUND OR SET AND SIGN POST.

ORIGINAL CORNER SET IN NOVEMBER, 1852, BY RICK CHANEY. DAVID AMENT, LOCAL LAND OWNER, SAID THAT IN THE 40'S, A LARGE FOREST FIRE BURNT EVERYTHING IN THIS TOWNSHIP. THERE ARE NO LARGE STUMPS IN THIS SECTION. ORIGINAL TIES, SUGAR 12", N18°E 31 LINKS; BIRCH 10", S43°W, 26 LINKS NO EVIDENCE FOUND OF ORIGINAL WOOD POST OR ORIGINAL TIES.

FOUND 1" IRON PIPE LEANING OVER. HELD AS CORNER. WHEN WE SET BERNTSEN MONUMENT, WE DUG UP MANY SMALL ROCKS, AS IF ROCKS HAD BEEN PILED AROUND SOMETHING HERE (ORIGINAL WOOD POST?) HIT LARGE ROCK, HAD TO LEAVE BERNTSEN STICK UP 6", TIED OUT.

(c) (d) (e) PLAN VIEW OF CORNER WITH TIES TO AT LEAST 4 WITNESS MONUMENTS. IF IN DISAGREEMENT WITH PREVIOUSLY ESTABLISHED CORNER, SHOW THE DISTANCES BETWEEN THE TWO CORNERS AND ALSO INDICATE THE TIES TO THE DISPUTED CORNER.

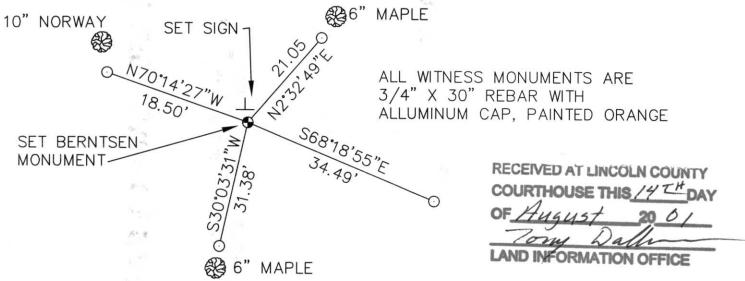

(i) I, DAVID L. OSTERBRINK
(TYPE OR PRINT NAME) CERTIFY THAT THE CORNER
LOCATION ON THIS RECORD WAS DETERMINED BY ME
OR UNDER MY DIRECTION AND CONTROL AND THAT
THIS U.S. PUBLIC LAND SURVEY MONUMENT RECORD
IS CORRECT AND COMPLETE TO THE BEST OF MY
KNOWLEDGE AND BELIEF.

SIGNATURE DATE



SECTION SUMMARY, SECTIONS 9 & 10, T 32N, R5E, TOWN OF HARDING

