

CERTIFIED LAND CORNER RESTORATION


Index No. S-1

State of Wisconsin }
County of Lincoln } ss.

I Sheridan D. Schwark, do hereby certify that on the 19th day of June, 1978, I found evidence of the West one-quarter corner of Section 30 Township 32, North, Range 6 East, Fourth, Principal Meridian, as described hereon; and that from this evidence I established a new monument and accessories as described hereon to perpetuate the original location of this corner.

Resident witnesses:

.....
.....
.....

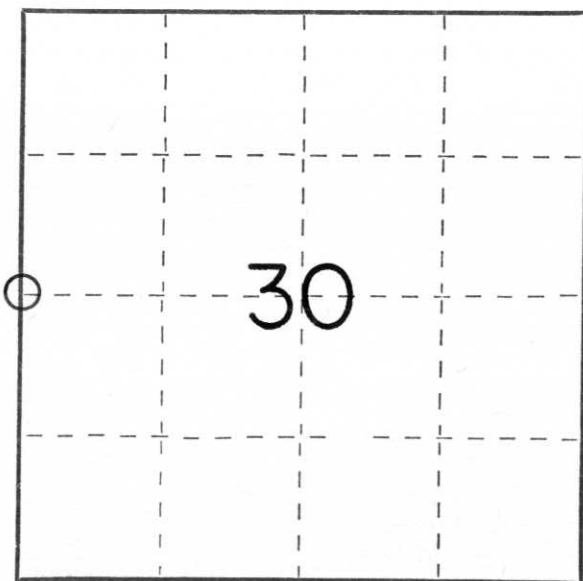

○ = Corner monument restored.

History of original corner establishment:

Date: July & August, 1851
Surveyor: James M. Marsh
Monument: Wood Post
Witnesses: 10" Birch, S13°E, 9 links
10" Birch, S 6°W, 31 links
11" Birch, N12°W, 49 links
9" Birch, N40°E, 18 links

Description of corner evidence found:

I used the fence line intersection because there was no other evidence on record or found. The fences look to be old and used by adjoining property owners.

Description of monument and accessories I established to perpetuate the original location of this corner.

We set a Lincoln County Berntsen Monument having the following witness monuments:

- 1 1/4" x 30" solid round iron rod set approximately 1' South of fence intersection bearing N2°E, 68.91'
- 1 1/4" x 30" solid round iron rod set approximately 1' West of fence post bearing S83°E, 43.69'
- 1 1/4" x 30" solid round iron rod set bearing S2°W, 11.74'
- 1 1/4" x 30" solid round iron rod set West of fence corner bearing S83°W, 3.75'

Dated at Merrill, Wis., this 23rd day of June, 1978.

Signature Sheridan D. Schwark Title Registered Land Surveyor Registration No. S-1205
(County Surveyor, Registered Land Surveyor, or other duly authorized official)

Office of Register of Deeds, County of _____, I hereby certify that the within instrument was filed in this office for record on the _____ day of _____, 19____ at _____ o'clock _____ M.

.....
(Register of Deeds)

By _____ Deputy



2002 11 20



2002 11 20



