

CERTIFIED LAND CORNER RESTORATION

Index No. 5-5

State of Wisconsin }
County of Lincoln } ss.

I, Robert H. Winat, do hereby certify that on the 12th day of June, 19 72, I found evidence of the West 1/4 corner of Section 29 Township 32, North, Range 5 East, Fourth, Principal Meridian, as described hereon; and that from this evidence I established a new monument and accessories as described hereon to perpetuate the original location of this corner.

Resident witnesses:

History of original corner establishment:

Surveyor: Richard Chaney
Date: November, 1852
Monumentation: Wood post
Witnesses: 7" Birch N52°E, 4 lks.
9" Birch S21°W, 32 lks.

Description of corner evidence found:


Found 3" sq. wood (Tamarack) stake scribed Ⓟ 1/4 S on old E-W blazed line about 30'E of old blazed line North. I believe that D. H. Vaughan probably set this post, but can't find a record of this.

18" White Pine tipped to 25° from horizontal - cut into base about 30 yrs. ago - scribed 1/4, N38°W, 5.0' 6"+ Birch Stump in mound in swamp (regrowth of original (?), S13°W, 18.0'
2' high mound in swamp (remains of NE original BT?) NE, 3'+

Description of monument and accessories I established to perpetuate the original location of this corner.

Set Lincoln County Berntsen monument -36" - reset remains of old post alongside

P.K. Nail in 6" Maple N75°E, 14.01'
P.K. nail in 5" B.Spruce S69°W, 25.47'
P.K. nail in 6" B.Spruce N29°W, 22.84'

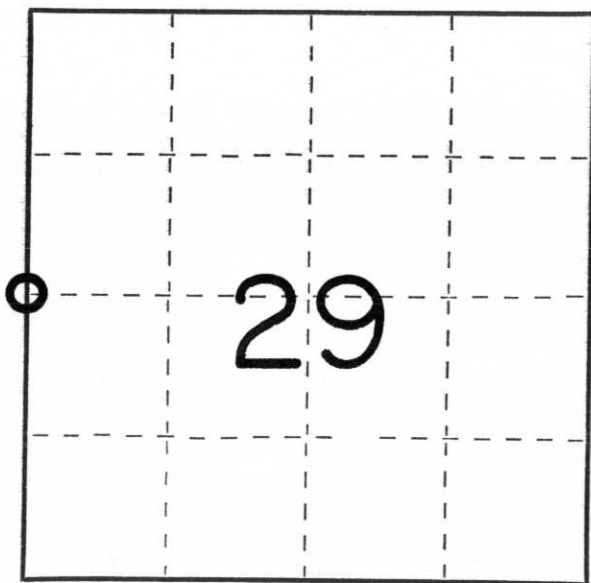

○ = Corner monument restored.

Dated at Minocqua, Wis., this 21st day of November, 19 74

Signature Robert H. Winat Title Land Surveyor Registration No. S-1040
(County Surveyor, Registered Land Surveyor, or other duly authorized official)

Office of Register of Deeds, County of _____, I hereby certify that the within instrument was filed in this office for record on the _____ day of _____, 19 _____ at _____ o'clock _____ M.

(Register of Deeds)

By _____ Deputy