
U.S. PUBLIC LAND SURVEY MONUMENT RECORD

The state of the s	
Note: This form is intended and designed to fulfill all requirements of Wisconsin Adminis Public Land Survey Monument Record (3) (a) (b) (c) (d) (e) (f) (g) (h) (i). An addition conform with said requirements.	strative Code, Chapter A-E 5.02, U.S al sheet may be added if necessary to
(a) Corner location: Township 31 North	
Range 5 East	
Town/City/VillageCORNING	
County LINCOLN	

(b) (f) (g) (h) Description of monument found at this corner and if it was accepted, state all evidence (material, testimonial, occupational, plats, records, other monuments) used as a basis for accepting. If not accepted or if nothing was found, state evidence used as basis for establishing location. If reestablished through lost corner proportionate methods, indicate all monuments, distances and directions used to establish.

There was no local testimony available that had witnessed a stone in this area. I dug at the centerline of the existing road (Craneberry Trail) at 80.07 chains (original chainage) east of the northwest corner of said section. I found no evidence. I accepted this location as the correct position for remonumenting this corner.

(c) (d) (e) Plan view of corner with ties to at least 4 witness monuments. If in disagreement with previously established corner, show the distances between the two corners and also indicate the ties to the disputed corner.

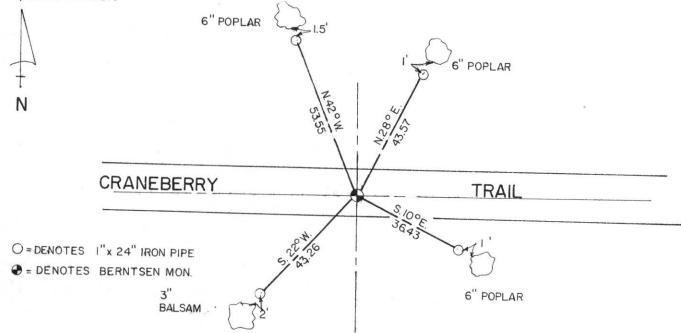

(i) I. THOMAS A. RADENZ

(type or print name) certify that the corner location on this record was determined by me or under my direction and control and that this U.S. Public Land Survey Monument Record is correct and complete to the best of my knowledge and belief.

Signature

Mannas A. Raden

12.28 - 93 Date



Section.

Index No. A-5





