

CERTIFIED LAND CORNER RESTORATION

Index No. A-17

State of Wisconsin }
County of LINCOLN } ss.

History of original corner establishment:

OLD STONE MONUMENT

I FRANCIS X. FOX, do hereby certify that on the 3RD day of JUNE, 1974, I found evidence of the NORTHWEST corner of SECTION 2 Township 31, North, Range 5 EAST, Fourth, Principal Meridian, as described hereon; and that from this evidence I established a new monument and accessories as described hereon to perpetuate the original location of this corner.

Description of corner evidence found:

STONE 3 1/2" BELOW ROAD SURFACE


Resident witnesses:

.....
.....
.....

Description of monument and accessories I established to perpetuate the original location of this corner.

PLACED IRON SHAFT OVER TOP OF STONE 1 1/8" DIA. 6" BELOW ROAD SURFACE. SET IRON REFERENCE STAKES. DUE NORTH 33' AND 53' RESPECTIVELY

13.

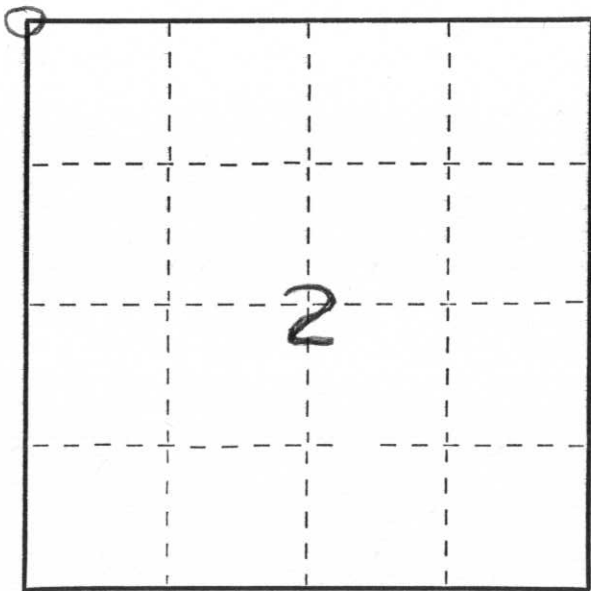

○ = Corner monument ~~restored~~
FOUND

Dated at MERRILL, Wis., this 5TH day of JUNE, 1974.

Signature Francis X. Fox Title LAND SURVEYOR Registration No. 46
(County Surveyor, Registered Land Surveyor, or other duly authorized official)

Office of Register of Deeds, County of....., I hereby certify that the within instrument was filed in this office for record on the..... day of....., 19..... at.....o'clock..... M.

.....
(Register of Deeds)

By.....Deputy