
U.S. PUBLIC LAND SURVEY MONUMENT RECORD

Note: This form is intended and designed to fulfill all requirements of Wisconsin Administrative Consultant Survey Monument Record (3) (a) (b) (c) (d) (e) (f) (g) (h) (i). An additional sheet make the conform with said requirements.	ode, Chapter A-E 5.02, U.S. hay be added if necessary to
(a) Corner location: Township 32 North	LITTIP
Range5East	
Town/City/VillageHarding	
CountyLincoln	

(b) (f) (g) (h) Description of monument found at this corner and if it was accepted, state all evidence (material, testimonial, occupational, plats, records, other monuments) used as a basis for accepting. If not accepted or if nothing was found, state evidence used as basis for establishing location. If reestablished through lost corner proportionate methods, indicate all monuments, distances and directions used to establish.

Dug area completely and found no evidence of corner. Set corner on centerline of road at equal distance from SW Cor. to SE Cor. Fits old wire to the South. Set Bernsten Monument at approx. 8" below road surface. Tied out.

(c) (d) (e) Plan view of corner with ties to at least 4 witness monuments. If in disagreement with previously established corner, show the distances between the two corners and also indicate the ties to the disputed corner.

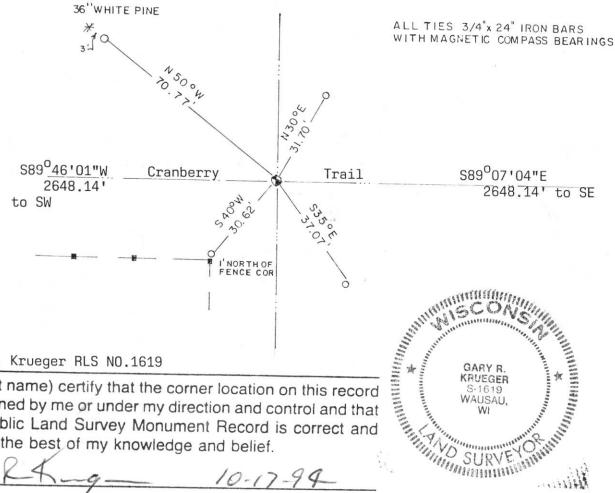

Gary R. Krueger RLS NO.1619

(type or print name) certify that the corner location on this record was determined by me or under my direction and control and that this U.S. Public Land Survey Monument Record is correct and complete to the best of my knowledge and belief.

Signature Date





