

CERTIFIED LAND CORNER RESTORATION


Index No. 45 M-23

State of Wisconsin }
County of Lincoln } ss.

I Sheridan D. Schwark, do hereby
certify that on the 27th day
of November, 19 77, I found
evidence of the S. one-quarter
corner of Section 13
Township 32, North, Range
6 East, Fourth, Principal Meridian,
as described hereon; and that from this evidence
I established a new monument and accessories
as described hereon to perpetuate the original
location of this corner.

Resident witnesses:

.....
.....
.....

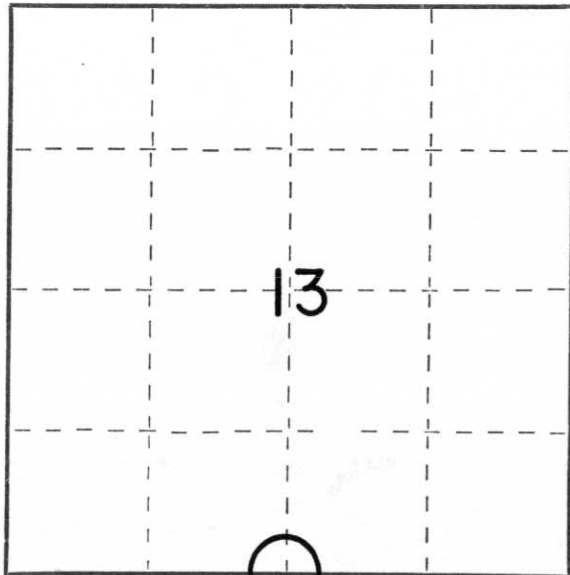

○ = Corner monument restored.

History of original corner establishment:

Date: November, 1852
Surveyors: Albert & Frederick Ellis
Monument: Wood post
Witnesses: 10" hemlock, N38°W, 32 links
3" " S25°E, 28 links

Description of corner evidence found:

We were unable to find evidence of any original corner or bearing trees. An existing fenceline which travelled North-South and East fit distances to the existing SW corner and N ¼ reasonably well. We therefore set the corner at the fenceline intersection, figuring it was the best available evidence.

Description of monument and accessories I established to perpetuate the original location of this corner.

Set a Lincoln county Berntsen monument with the following witness monuments:

3/4" x 30" round iron rod, bearing N2°W, 24.60'
" " " " " S89°E, 30.03'
" " " " " S1°W, 15.74'
" " " " " S86°W, 15.34'

Dated at MERRILL, Wis., this 28th day of NOVEMBER, 19 77.

Signature Sheridan D. Schwark Title Registered Land Surveyor Registration No. S-1205
(County Surveyor, Registered Land Surveyor, or other duly authorized official)

Office of Register of Deeds, County of....., I hereby certify that the within
instrument was filed in this office for record on the.....day of....., 19.....
at.....o'clock..... M.

.....
(Register of Deeds)

By.....Deputy



10 12:21 PM



10 12:21 PM



10 12:22 PM