


CERTIFIED LAND CORNER RESTORATION

Index No. 0-19

State of Wisconsin }
County of LINCOLN } ss.

I EDWIN R. ABENDROTH, do hereby certify that on the 5TH day of MAY, 19 78, I found evidence of the NORTH 1/4 corner of SEC. 35 Township 32, North, Range 6 EAST, Fourth, Principal Meridian, as described hereon; and that from this evidence I established a new monument and accessories as described hereon to perpetuate the original location of this corner.

Resident witnesses:

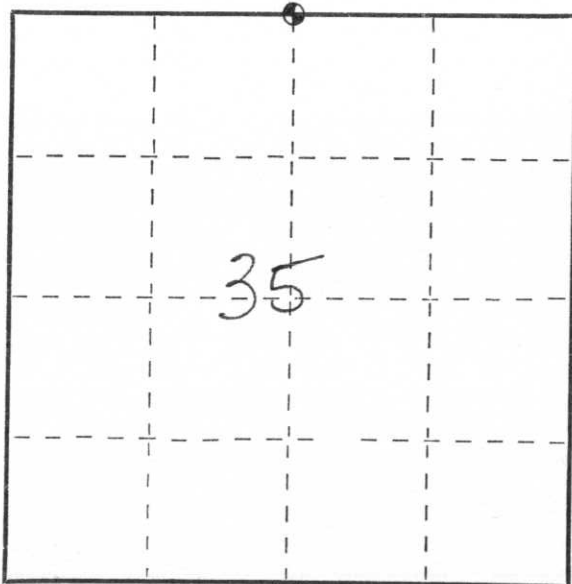


○ = Corner monument restored.

History of original corner establishment:

40.12 SET 1/4 SECTION POST
TAMARACK 12 S45°W 2
BIRCH 10 N13°W 5

Description of corner evidence found: NO ORIGINAL EVIDENCE AT COR. LOCATION

Description of monument and accessories I established to perpetuate the original location of this corner

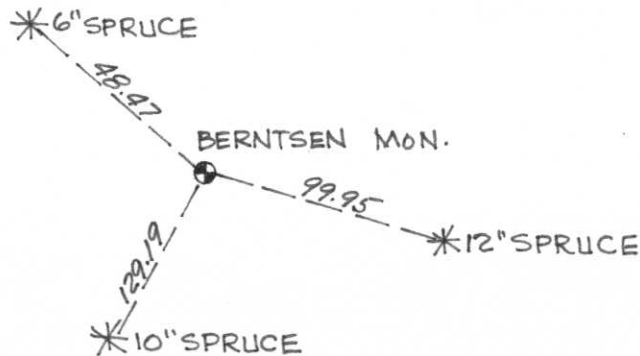

Dated at WAUSAU, Wis., this 14TH day of JUNE, 19 78.

Signature Edwin R. Abendroth Title R.L.S. Registration No. S-798
(County Surveyor, Registered Land Surveyor, or other duly authorized official)

Office of Register of Deeds, County of _____, I hereby certify that the within instrument was filed in this office for record on the _____ day of _____, 19 _____ at _____ o'clock _____ M.

(Register of Deeds)

By _____ Deputy



2002 11 14



2002 11 14