

CERTIFIED LAND CORNER RESTORATION


Index No. 0-3

State of Wisconsin }
County of Lincoln } ss.

I Sheridan D. Schwark, do hereby certify that on the 19th day of June, 1978, I found evidence of the South one-quarter corner of Section 30 Township 32, North, Range 6 East, Fourth, Principal Meridian, as described hereon; and that from this evidence I established a new monument and accessories as described hereon to perpetuate the original location of this corner.

Resident witnesses:

.....
.....
.....

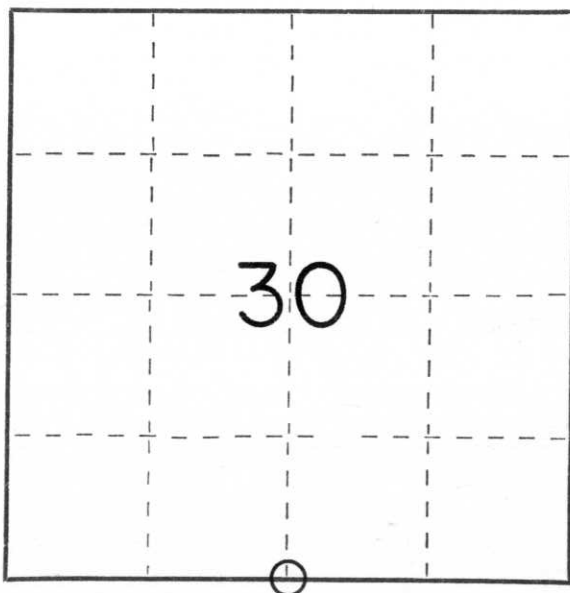

○ = Corner monument restored.

History of original corner establishment:

Date: April, 1852
Surveyor: A.G. & F.S. Ellis
Monument: Wood Post
Witnesses: 18" Hemlock, S46°W, 17 links
15" Hemlock, N61°W, 36 links

Description of corner evidence found:

I set the corner by proportionate methods because the only evidence available was a fence line which was discredited by an elderly resident.

Description of monument and accessories I established to perpetuate the original location of this corner.

We set a Lincoln County Berntsen Monument having the following witness monuments:
1 1/4" x 30" solid round iron rod set approximately 2' Southwest of blacktop edge of S.T.H. "107" bearing N38°E, 84.56'
1 1/4" x 30" solid round iron rod set approximately 3' South of power pole bearing S67°E, 42.96'
1 1/4" x 30" solid round iron rod set approximately 2' North of 3" Norway Pine bearing S9°E, 70.55'
1 1/4" x 30" solid round iron rod set approximately 2' North of 3" Norway Pine bearing S28°W, 74.31'

Dated at Merrill, Wis., this 23rd day of June, 1978.

Signature Sheridan D. Schwark Title Registered Land Surveyor Registration No. S-1205
(County Surveyor, Registered Land Surveyor, or other duly authorized official)

Office of Register of Deeds, County of _____, I hereby certify that the within instrument was filed in this office for record on the _____ day of _____, 19____ at _____ o'clock _____ M.

.....
(Register of Deeds)

By _____ Deputy



2002 7 18



2002 7 18



2002 7 18



2002 7 18