

CERTIFIED LAND CORNER RESTORATION


Index No. S-5

State of Wisconsin }
County of Lincoln } ss.

I Sheridan D. Schwark, do hereby certify that on the 20th day of June, 1978, I found evidence of the East one-quarter corner of Section 30 Township 32, North, Range 6 East, Fourth, Principal Meridian, as described hereon; and that from this evidence I established a new monument and accessories as described hereon to perpetuate the original location of this corner.

Resident witnesses:

.....
.....
.....

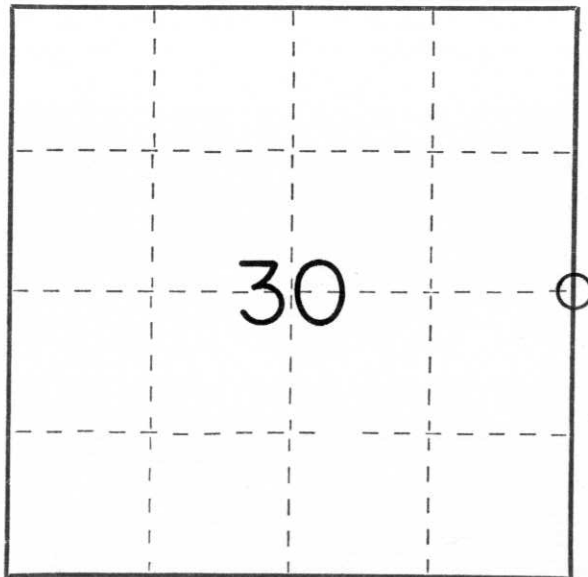

○ = Corner monument restored.

History of original corner establishment:

Date: April, 1852
Surveyor: A.G. & F.S. Ellis
Monument: Wood Post
Witnesses: 9" Hemlock, S47°E, 19 links
8" Hemlock, S72°W, 16 links

Description of corner evidence found:

I used a fence line running East and West for North, South position and a line between the Northeast and Southeast corners of Section 30 for East, West line because it fit the road centerline reasonably well. We excavated the road in this area with a backhoe below the original grade and found no evidence of a corner.

Description of monument and accessories I established to perpetuate the original location of this corner.

We set a Lincoln County Berntsen Monument having the following witness monuments:

- 1 1/4" x 30" solid round iron rod set approximately 1' West of 2" blazed Norway Pine bearing N32°E, 57.98'
- 1 1/4" x 30" solid round iron rod set approximately 1' West of a 8" blazed Poplar bearing S39°E, 47.25'
- 1 1/4" x 30" solid round iron rod set approximately 1' East of a 5" blazed Maple bearing S34°W, 61.86'
- 1" iron pipe found in place approximately 1' West of end fence post bearing S86°W, 34.70'

Dated at Merrill, Wis., this 23rd day of June, 1978

Signature Sheridan D. Schwark Title Registered Land Surveyor Registration No. S-1205
(County Surveyor, Registered Land Surveyor, or other duly authorized official)

Office of Register of Deeds, County of _____, I hereby certify that the within instrument was filed in this office for record on the _____ day of _____, 19____ at _____ o'clock _____ M.

.....
(Register of Deeds)

By _____ Deputy



2002 7 18



2002 7 18



2002 7 18



2002 7 18