

LINCOLN COUNTY U.S. PUBLIC LAND SURVEY MONUMENT LOCATION RECORD

SECTION 5
TOWNSHIP 31N
RANGE 6E

A-5
NO.

LANDMARK BENCHMARK _____

FOUND
SET
RESET
RE-TIED

CORNER IDENTITY: 8"x8" GRANITE STONE MONUMENT

SCOTT
CITY, VILLAGE, TOWN

LINCOLN COUNTY COORDINATE: N: _____


E: _____

ELEVATION-(FEET): _____ DATUM: _____

WEATHER: OVERCAST

DATE OF SURVEY: 11/18/21 TEMPERATURE: 40 °F

SURVEY PARTY: SAM HAUGEN & COLLIN MARQUARDT

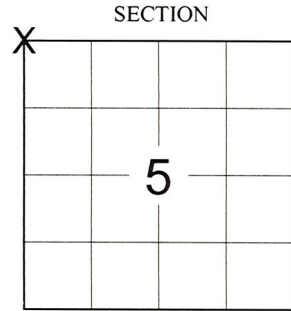


LOCATION
(Indicated By X)



BASIS FOR MONUMENT LOCATION:
(DESCRIBE METHOD OF SURVEY AND CORNER AUTHENTICATION)

9/16/1980 - D. Tlusty & S. Ulrich visited this corner location, found 8"x8" square granite monument 2.0' out of ground at fence corner.

11/18/2021 - We visited this corner and found 8"x8" granite stone laying flat on ground. Land owner to East said stone was knocked out when trail was plowed during winter of 2020-2021. No ties remained, reset stone at position provided by public county coordinates with top of stone being 1' above ground. Set 4 (four) new ties to perpetuate the corner location as shown below. Set metal T-post and new vinyl post along West and South sides of stone.

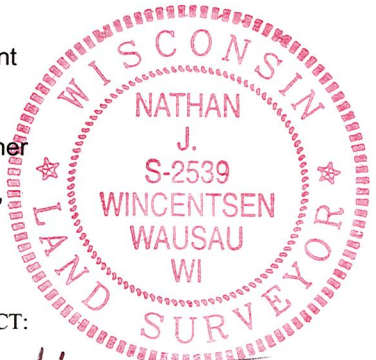

CERTIFIED CORRECT:

Nathan J. Wincentesen

NATHAN J. WINCENTSEN S-2539
Professional Land Surveyor

DATE: 1-26-22


FIELD BOOK NO. NA PAGE NO. NA

COMPANY RIVERSIDE LAND SURVEYING LLC

TIE SKETCH:


- 8"x8" GRANITE STONE MONUMENT
- SET 7/8"x30" REBAR WITH 2-1/2" O.D. ALUMINUM CAP
- SET VINYL "T" POST

RECEIVED BY LINCOLN COUNTY
SURVEYOR THIS 27TH DAY
OF January 20 22
Tony Dahl
COUNTY SURVEYOR

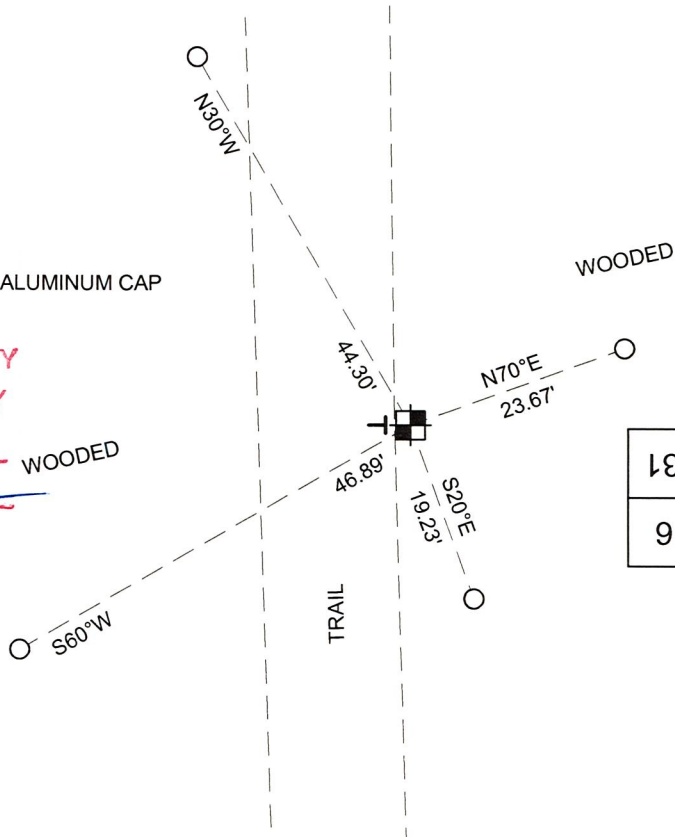

13	32
9	5

TOP OF STONE
SCRIBED AND
PLACED AS SHOWN

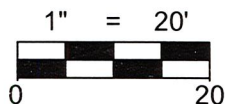

BEARINGS WERE ESTABLISHED FROM A
MAGNETIC HAND HELD COMPASS READING.

A-5
NO.
4-5


MINK CAPITAL SURVEYING, INC.
SURVEY MONUMENT LOCATION RECORD

SECTION 5
 TOWNSHIP 31
 RANGE 6E
LINCOLN
 [CITY, VILLAGE, COUNTY]

LANDMARK BENCHMARK

FOUND
 SET
 RE-SET
 RE-TIED

CORNER IDENTITY NORTHWEST CORNER SEC 5
 DATE OF SURVEY SEPT 16, 1980
 WEATHER PTLY CLDY WINDY
 TEMPERATURE 65°
 SURVEY PARTY D. TLUSTY S. ULRICH

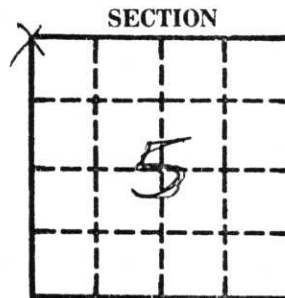


SECTION
 LOCATION [INDICATED BY X]



BASIS FOR MONUMENT LOCATION


DESCRIBE METHOD OF SURVEY AND CORNER AUTHENTICATION

Found 8"x8" SQUARE GRANITE MONUMENT 2.0' OUT OF GROUND AT FENCE CORNER. ~~THE~~ MONUMENT SCRIBED AS SHOWN BELOW

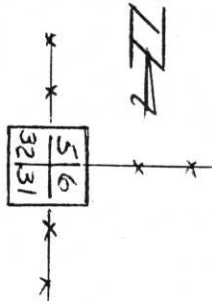

TIE SKETCH

SHOW HORIZONTAL TIE DISTANCES TO FIXED WITNESS MONUMENTS. DESCRIBE ALL MONUMENTS FOUND OR SET.

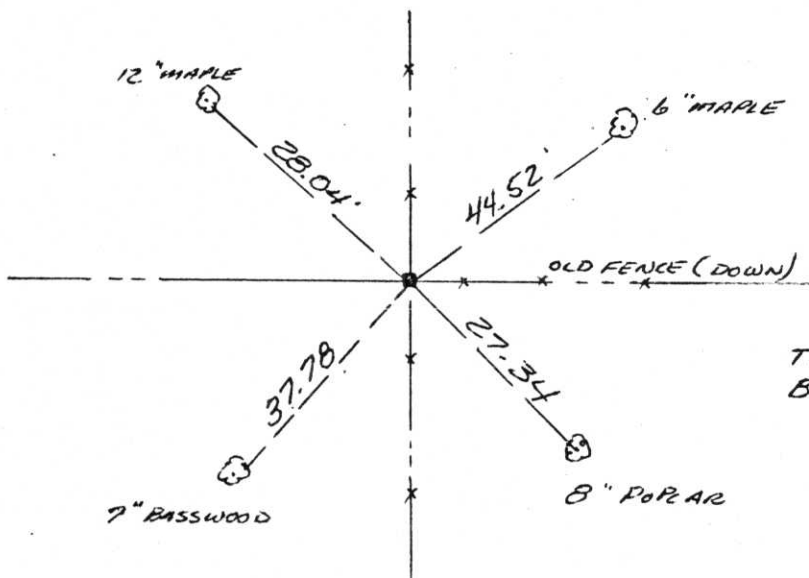

TIED TO NAILS + BOTTLECAPS IN BLAZES

RECEIVED AT THE COUNTY
 COURTHOUSE
 OF
 TAX

A-5