


MINK CAPITAL SURVEYING, INC.
SURVEY MONUMENT LOCATION RECORD

SECTION 5
 TOWNSHIP 31
 RANGE 6E
LINCOLN
 [CITY, VILLAGE, COUNTY]

LANDMARK BENCHMARK

FOUND
 SET
 RE-SET
 RE-TIED

CORNER IDENTITY NORTHWEST CORNER SEC 5
 DATE OF SURVEY SEPT 16, 1980
 WEATHER PTLY CLDY WINDY
 TEMPERATURE 65°
 SURVEY PARTY D. TLUSTY S. ULRICH

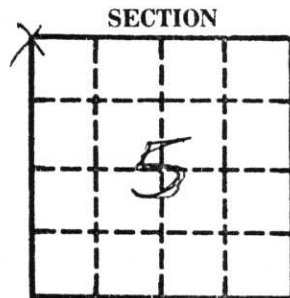


LOCATION [INDICATED BY X]



BASIS FOR MONUMENT LOCATION


DESCRIBE METHOD OF SURVEY AND CORNER AUTHENTICATION

Found 8"x8" SQUARE GRANITE MONUMENT 2.0' OUT OF GROUND AT FENCE CORNER. ~~THE~~ MONUMENT SCRIBED AS SHOWN BELOW

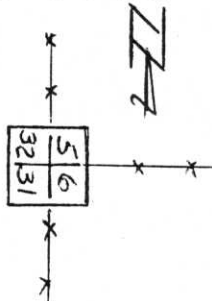

TIE SKETCH

SHOW HORIZONTAL TIE DISTANCES TO FIXED WITNESS MONUMENTS. DESCRIBE ALL MONUMENTS FOUND OR SET.

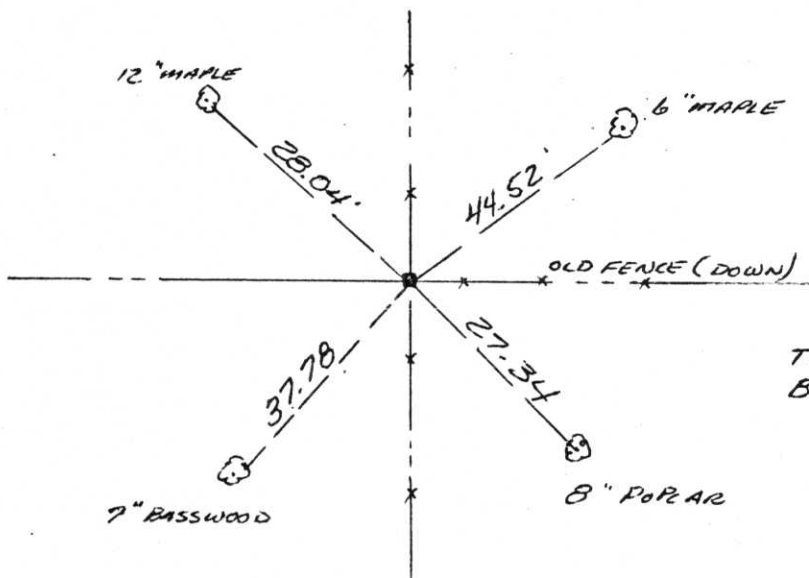

TIED TO NAILS + BOTTLECAPS IN BLAZES

RECEIVED AT THE COUNTY
 COURTHOUSE
 OF
 TAX

A-5