

CERTIFIED LAND CORNER RESTORATION


Index No. A-3

State of Wisconsin }
 County of Lincoln } ss.

I Edwin R. Abendroth, do hereby certify that on the 28th day of November, 1984, I found evidence of the North 1/4 corner of Section 6 Township 31, North, Range 6 East, Fourth, Principal Meridian, as described hereon; and that from this evidence I established a new monument and accessories as described hereon to perpetuate the original location of this corner.

Resident witnesses:

.....

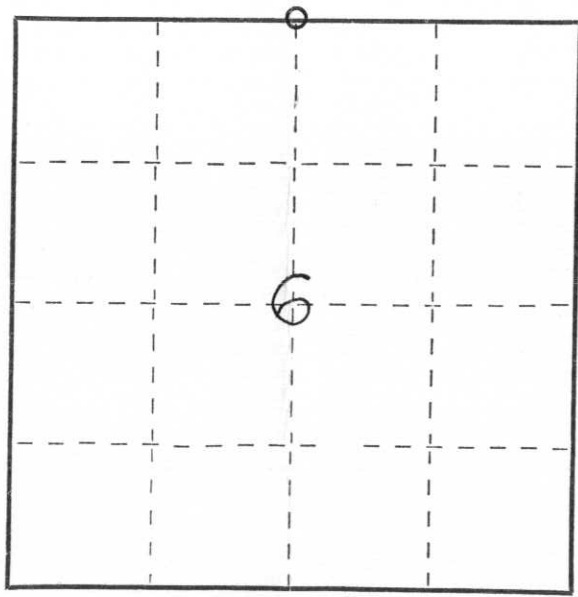

○ = Corner monument restored.


History of original corner establishment:

Wood Post set on original Government Survey

Description of corner evidence found:
 Reconstructed survey done by Owen Ayres Assoc. when a 2" iron pipe was found and tied. Could not find iron pipe. Spoke with local resident who stated iron pipe was pulled out. Set Berntsen Monument at surveyed location.



Description of monument and accessories I established to perpetuate the original location of this corner.

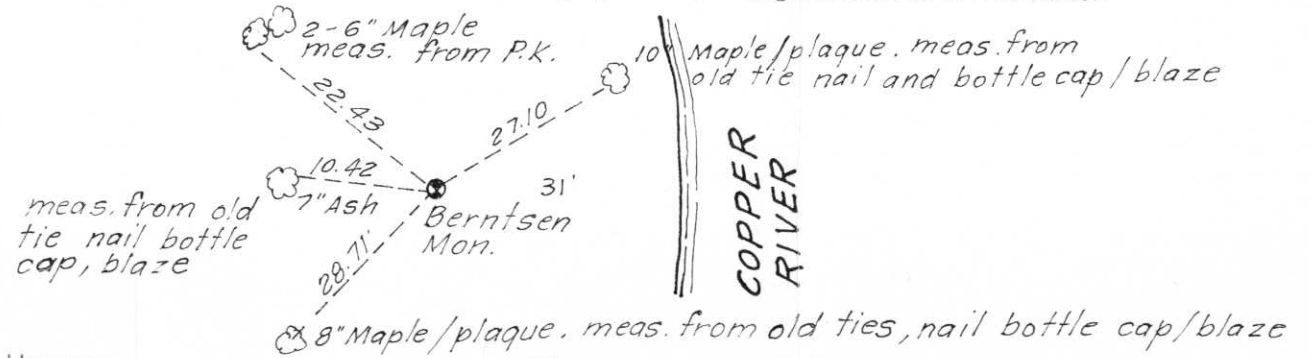

Dated at Wausau, Wis., this 30 day of November, 1984

Signature Edwin R. Abendroth Registr Land Surveyor Registration No. S-798
 (County Surveyor, Registered Land Surveyor, or other duly authorized official)

Office of Register of Deeds, County of Lincoln, I hereby certify that the within instrument was filed in this office for record on the day of, 19..... at o'clock M.

.....
 (Register of Deeds)

By..... Deputy