

LINCOLN COUNTY U.S. PUBLIC LAND SURVEY MONUMENT LOCATION RECORD

SECTION 2
TOWNSHIP 31 N
RANGE 6 E

A-17
NO.

LANDMARK BENCHMARK
CORNER IDENTITY: LINCOLN COUNTY BERNTSEN MONUMENT
FOUND SET
RESET RE-TIED

LINCOLN COUNTY COORDINATE: N: 132049.260
E: 385982.238


ELEVATION-(FEET): _____ DATUM: NAD 83 (2011)

WEATHER: CLOUDY

DATE OF SURVEY: 5-2-2018 TEMPERATURE: 60 °F

SURVEY PARTY: KEITH WALKOWSKI / AUSTIN PELOT

MERRILL
CITY, VILLAGE, TOWN

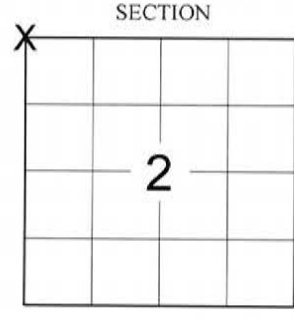

BASIS FOR MONUMENT LOCATION:
(DESCRIBE METHOD OF SURVEY AND CORNER AUTHENTICATION)

SEARCHED FOR THE NORTHWEST CORNER AND FOUND A STAMPED BERNTSEN MONUMENT AND ONE TIE FROM THE 1978 TIESHEET BY SHERIDAN SCHWARK. ACCEPTED THE BERNTSEN MONUMENT AS THE CORNER AND ADDED TIES TO PERPETUATE THE CORNER LOCATION AS SHOWN BELOW.



FIELD BOOK NO. NA PAGE NO. NA

COMPANY RIVERSIDE LAND SURVEYING LLC

CERTIFIED CORRECT:

Keith J. Walkowski
KEITH J. WALKOWSKI S-2717
Professional Land Surveyor
DATE: MAY 15TH, 2018

TIE SKETCH:

- FOUND LINCOLN COUNTY BERNTSEN MONUMENT
- SET 1" REBAR WITH ALUMINUM CAP
- FOUND 1-1/4" O.D. IRON PIPE
- EXISTING SIGN

RECEIVED BY LINCOLN COUNTY
SURVEYOR THIS 15TH DAY
OF May 20 / 18
Zany Dahl
COUNTY SURVEYOR



BEARINGS ARE BASED ON THE LINCOLN COUNTY COORDINATE SYSTEM NAD 83 (2011) AND REFERENCED AS SHOWN
THIS DRAWING IS NOT TO SCALE

A-17
NO.

CERTIFIED LAND CORNER RESTORATION


Index No. A-17

State of Wisconsin }
County of Lincoln } ss.

I Sheridan D. Schwark, do hereby certify that on the 12th day of April, 1978, I found evidence of the Northwest corner of Section 2 Township 31, North, Range 6 East, Fourth, Principal Meridian, as described hereon; and that from this evidence I established a new monument and accessories as described hereon to perpetuate the original location of this corner.

Resident witnesses:

.....
.....
.....

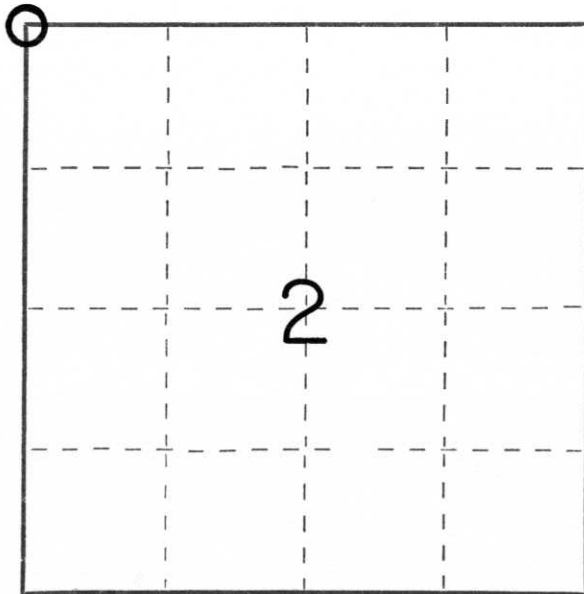

○ = Corner monument restored.

History of original corner establishment:

Date: June, 1851
Surveyor: James M. Marsh
Monument: Wood post
Witnesses: 18" Birch N35°E 30 links
16" Hemlock S22°E 20 "
16" " S88°W 14 "
16" " N35°W 39 "

Description of corner evidence found:

We found a very old 2" iron pipe in the intersection of a North-South and East-West road--Many old surveys had been referenced to this monument and I saw no reason to question its location.

Description of monument and accessories I established to perpetuate the original location of this corner.

We set a Lincoln County Berntsen monument with the following witness monuments:
1 1/4" x 30" iron pipe set 3' north of Stop sign, bearing S27°E 48.70'
1 1/4" x 30" iron pipe set 3' east of power pole No. 3206-35L8, bearing N54°E, 35.00'
1 1/4" x 30" iron pipe set 3' west of Stop sign, bearing N31°W, 26.47'
1 1/4" x 30" iron pipe set at the SW edge of the blacktop road, bearing S48°W, 35.40'

Dated at Merrill, Wis., this 14th day of April, 1978.

Signature Sheridan Schwark Title Registered Land Surveyor Registration No. S-1205
(County Surveyor, Registered Land Surveyor, or other duly authorized official)

Office of Register of Deeds, County of _____, I hereby certify that the within instrument was filed in this office for record on the _____ day of _____, 19____ at _____ o'clock _____ M.

.....
(Register of Deeds)

By _____ Deputy



24 2:51 PM



24 2:51 PM



24 2:53 PM