

CERTIFIED LAND CORNER RESTORATION

Index No. A-15

State of Wisconsin }  
 County of Lincoln } ss.


I Sheridan D. Schwark, do hereby certify that on the 12th day of April, 19 78, I found evidence of the North one-quarter corner of Section 3 Township 31 6 East, North, Range Fourth, Principal Meridian, as described hereon; and that from this evidence I established a new monument and accessories as described hereon to perpetuate the original location of this corner.

Resident witnesses:

.....

.....

.....

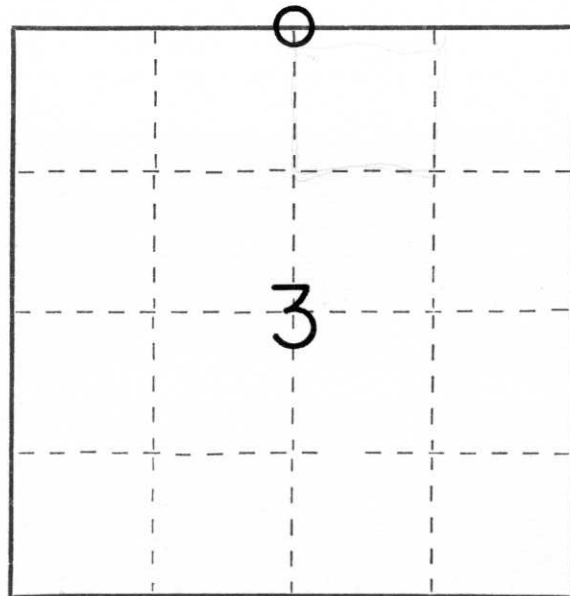

○ = Corner monument restored.

History of original corner establishment:

Date: June, 1851  
 Surveyor: James M. Marsh  
 Monument: Wood post  
 Witnesses: 8" Hemlock N72°E. 38 links  
               9" Birch S23°E. 20 "  
               11" Hemlock S84°W. 44 "  
               12" " N21°W. 30 "

Description of corner evidence found:

We excavated in the area of intersecting centerlines of a road running south and east from the corner, and in the area of intersecting f/lines from the north and west, and found nothing. Because the roads and fences could not be used to arrive at any single location, I felt that they were very poor evidence to use to establish a corner. Therefore, I set this corner using a single proportionate method between the N.W. and N.E. corners.

Description of monument and accessories I established to perpetuate the original location of this corner.

We set a Lincoln County Berntsen monument with the following witness monuments:  
 1 1/4" x 30" iron pipe set 3' north of iron fence post, bearing S38°E, 80.32'  
 1 1/4" x 30" iron pipe set at the north edge of blacktop road, bearing S76°E, 75.76'  
 1 1/4" x 30" iron pipe set in the east edge of farm road bearing N10°W, 49.58'  
 1 1/4" x 30" iron pipe set 3' east of power pole No. 3206-34L9, bearing S85°W, 51.20'

Dated at Merrill, Wis., this 14th day of April, 19 78.

Signature Sheridan Schwark Title Registered Land Surveyor Registration No. S-1205  
 (County Surveyor, Registered Land Surveyor, or other duly authorized official)

Office of Register of Deeds, County of \_\_\_\_\_, I hereby certify that the within instrument was filed in this office for record on the \_\_\_\_\_ day of \_\_\_\_\_, 19 \_\_\_\_\_ at \_\_\_\_\_ o'clock \_\_\_\_\_ M.

.....  
 (Register of Deeds)

By \_\_\_\_\_ Deputy



24 2:35 PM





24 2:36 PM





24 2:38 PM