

CERTIFIED LAND CORNER RESTORATION

Index No. E-23

State of Wisconsin }
 County of Lincoln } ss.


I Sheridan D. Schwark do hereby certify that on the 21st day of August, 1979, I found evidence of the south one-quarter corner of Section 1 Township 32 North, Range 7 East, Fourth, Principal Meridian, as described hereon; and that from this evidence I established a new monument and accessories as described hereon to perpetuate the original location of this corner.

Resident witnesses:

.....

.....

.....

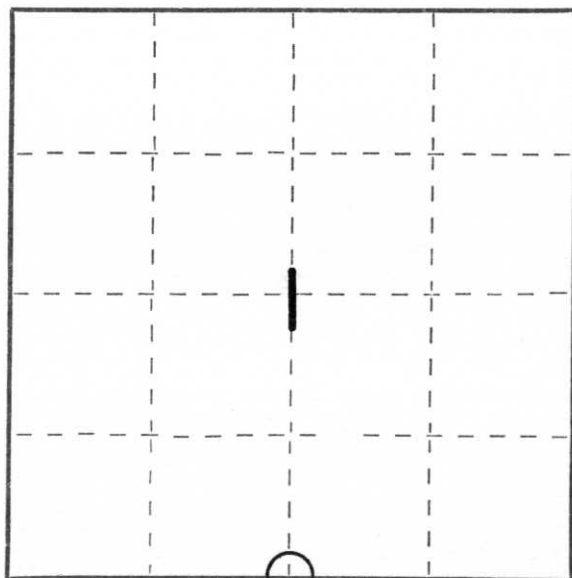

○ = Corner monument restored.


History of original corner establishment:

Date: April 1852
 Surveyor: A.G. & F.S. Ellis
 Monument: Wood Post
 Witnesses: 14" Elm S9W 24 links
 8" Fir N32W 20 links

Description of corner evidence found:

We excavated Heineman Road with a backhoe (A. Wyland operator) and found a red granite monument broken into two pieces. The top portion measured 7"x7"x11". We removed the base portion of the stone, which was upright and in good condition. It measured 7"x7"x20". We found it about 18" below grade and about 4' North of existing centerline of the granite road.

Description of monument and accessories I established to perpetuate the original location of this corner. We set a Lincoln County Berntsen Monument in the position of the base portion of the stone. The Berntsen is about 4" below grade.

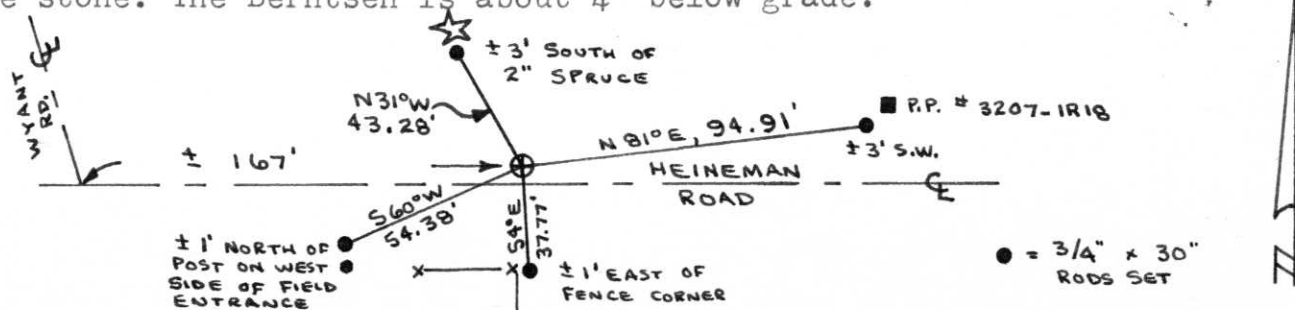

Dated at Wausau, Wis., this 14th day of September, 1979.

Signature Sheridan D. Schwark Title Registered Land Surveyor Registration No. S-1205
 (County Surveyor, Registered Land Surveyor, or other duly authorized official)

Office of Register of Deeds, County of....., I hereby certify that the within instrument was filed in this office for record on the.....day of....., 19..... at.....o'clock..... M.

(Register of Deeds)

By.....Deputy

