

CERTIFIED LAND CORNER RESTORATION

Index No. C-21

State of Wisconsin }
County of Lincoln } ss.

History of original corner establishment:

Wood post set by original government surveyor.

I Sheridan D. Schwark, do hereby certify that on the 15th day of October, 1980, I found evidence of the West one-quarter corner of Section 1 Township 32, North, Range 7 East, Fourth, Principal Meridian, as described hereon; and that from this evidence I established a new monument and accessories as described hereon to perpetuate the original location of this corner.


Description of corner evidence found:

We found a 6"x6" granite monument up .9'.


Resident witnesses:

.....
.....
.....

Description of monument and accessories I established to perpetuate the original location of this corner.

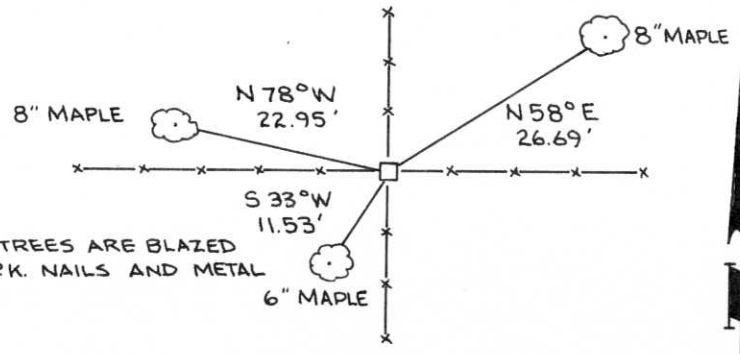

NOTE: ALL TREES ARE BLAZED AND HAVE P.K. NAILS AND METAL DISCS.

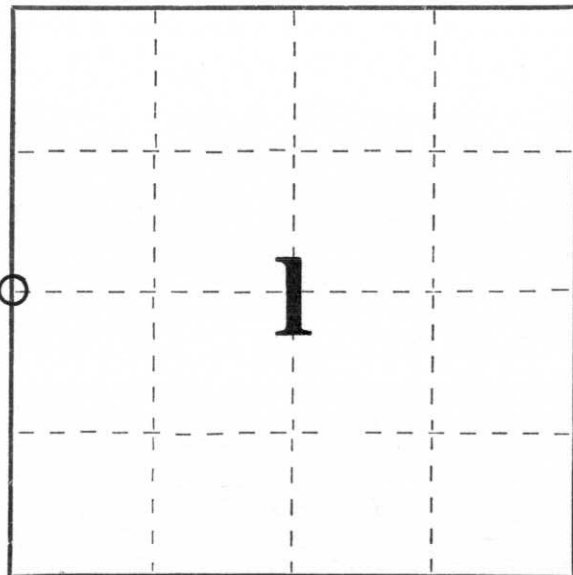

○ = Corner monument restored.

Dated at Merrill, Wis., this 23rd day of October, 1980

Signature Sheridan D. Schwark Title Registered Land Surveyor Registration No. S-1205
(County Surveyor, Registered Land Surveyor, or other duly authorized official)

Office of Register of Deeds, County of....., I hereby certify that the within instrument was filed in this office for record on the.....day of....., 19..... at.....o'clock..... M.

.....
(Register of Deeds)

By.....Deputy