

CERTIFIED LAND CORNER RESTORATION


Index No. 0-7

State of Wisconsin }  
County of Lincoln } ss.

I, Sheridan D. Schwark, do hereby certify that on the 19th day of April, 19 78, I found evidence of the North one-quarter corner of Section 32 Township 32, North, Range 7 East, Fourth, Principal Meridian, as described hereon; and that from this evidence I established a new monument and accessories as described hereon to perpetuate the original location of this corner.

Resident witnesses:

.....  
.....  
.....

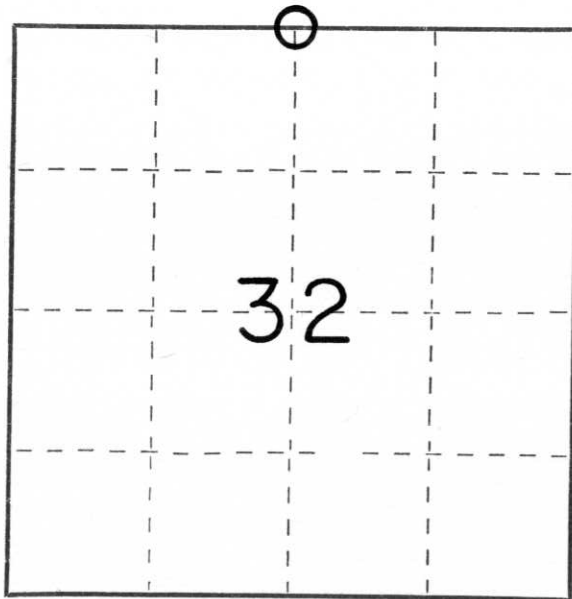

○ = Corner monument restored.

History of original corner establishment:

Date: April, 1852  
Surveyor: A.G. & P.S. Ellis  
Monument: Wood post  
Witnessess: 10" Tamarack S2°W, 28 links  
10" Tamarack N34°E, 18 links

Description of corner evidence found:

A 2" iron pipe was found. The pipe was established in 1962 by James G. Griffin, Registered Land Surveyor.

Description of monument and accessories I established to perpetuate the original location of this corner.

We set a Lincoln County Berntsen monument with the following witness monuments:  
13" Tamarack S22°E, 28.86'  
10" Tamarack N26°E, 45.67'  
1" iron pipe S26°W, 8.45'  
1" iron pipe N24°W, 7.22'

Dated at Merrill, Wis., this 20th day of April, 19 78.

Signature Sheridan D. Schwark Title Registered Land Surveyor Registration No. S-1205  
(County Surveyor, Registered Land Surveyor, or other duly authorized official)

Office of Register of Deeds, County of \_\_\_\_\_, I hereby certify that the within instrument was filed in this office for record on the \_\_\_\_\_ day of \_\_\_\_\_, 19 \_\_\_\_\_ at \_\_\_\_\_ o'clock \_\_\_\_\_ M.

.....  
(Register of Deeds)

By \_\_\_\_\_ Deputy





5 10:39 AM





5 10:38 AM