


# LINCOLN COUNTY U.S. PUBLIC LAND SURVEY MONUMENT LOCATION RECORD

SECTION 28  
TOWNSHIP 32N  
RANGE 7E

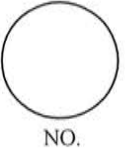

LANDMARK       BENCHMARK \_\_\_\_\_

FOUND   
SET   
RESET   
RE-TIED

CORNER IDENTITY: 6" SQUARE STONE

MERRILL  
CITY, VILLAGE, TOWN

LINCOLN COUNTY COORDINATE: N: 139992.195


E: 407415.763

ELEVATION-(FEET): \_\_\_\_\_ DATUM: NAD 83 (2011)

WEATHER: PARTLY SUNNY

DATE OF SURVEY: 11/9/2016 TEMPERATURE: 40 °F

SURVEY PARTY: KEITH WALKOWSKI / AUSTIN PELOT

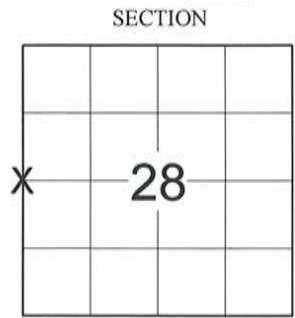

**BASIS FOR MONUMENT LOCATION:**  
(DESCRIBE METHOD OF SURVEY AND CORNER AUTHENTICATION)

SEARCHED FOR THE WEST 1/4 CORNER USING C.S.M. 1877. THE CORNER APPEARED TO HAVE BEEN PREVIOUSLY DUG WITH A COUNTY GRADALL. NO TIE SHEET OF RECORD COULD BE FOUND. WE DUG FOR THE STONE AND FOUND THE STONE WITH A REBAR ALONG THE NORTH SIDE 18" BELOW THE PAVEMENT. WE USED AN EXISTING LOT CORNER TO THE NORTHWEST AND SET THREE NEW TIES TO PERPETUATE THE CORNER LOCATION AS SHOWN.



FIELD BOOK NO. NA PAGE NO. NA  
COMPANY RIVERSIDE LAND SURVEYING LLC

CERTIFIED CORRECT:  
*Keith J. Walkowski*  
KEITH J. WALKOWSKI S-2717  
Professional Land Surveyor  
DATE: JANUARY 5TH, 2017

**TIE SKETCH:**

- 6" SQUARE STONE MONUMENT
- SET 1-1/4" O.D. x 24" IRON PIPE
- FOUND 1-1/4" O.D. IRON PIPE
- EXISTING UTILITY POLE
- STREET SIGN

**NOTE:**  
THE CORNER LIES 2' EAST AND 1.5' SOUTH OF THE CENTERLINE-CENTERLINE INTERSECTION.

RECEIVED BY LINCOLN COUNTY  
SURVEYOR THIS 9th DAY  
OF January 2017  
*Tommy Oak*  
COUNTY SURVEYOR

BEARINGS ARE BASED ON THE LINCOLN COUNTY COORDINATE SYSTEM NAD 83 (2011) AND REFERENCED AS SHOWN  
THIS DRAWING IS NOT TO SCALE

