


Project I.D. 1173-2-00 So. Co. Line
 -1.4 Mi. N. Merrill U.S.H. 51
 Freeway Lincoln County Wm. Scherer
 Surveyor Received from Division of
 Hwv's Jan. 11, 1973

REFERENCES

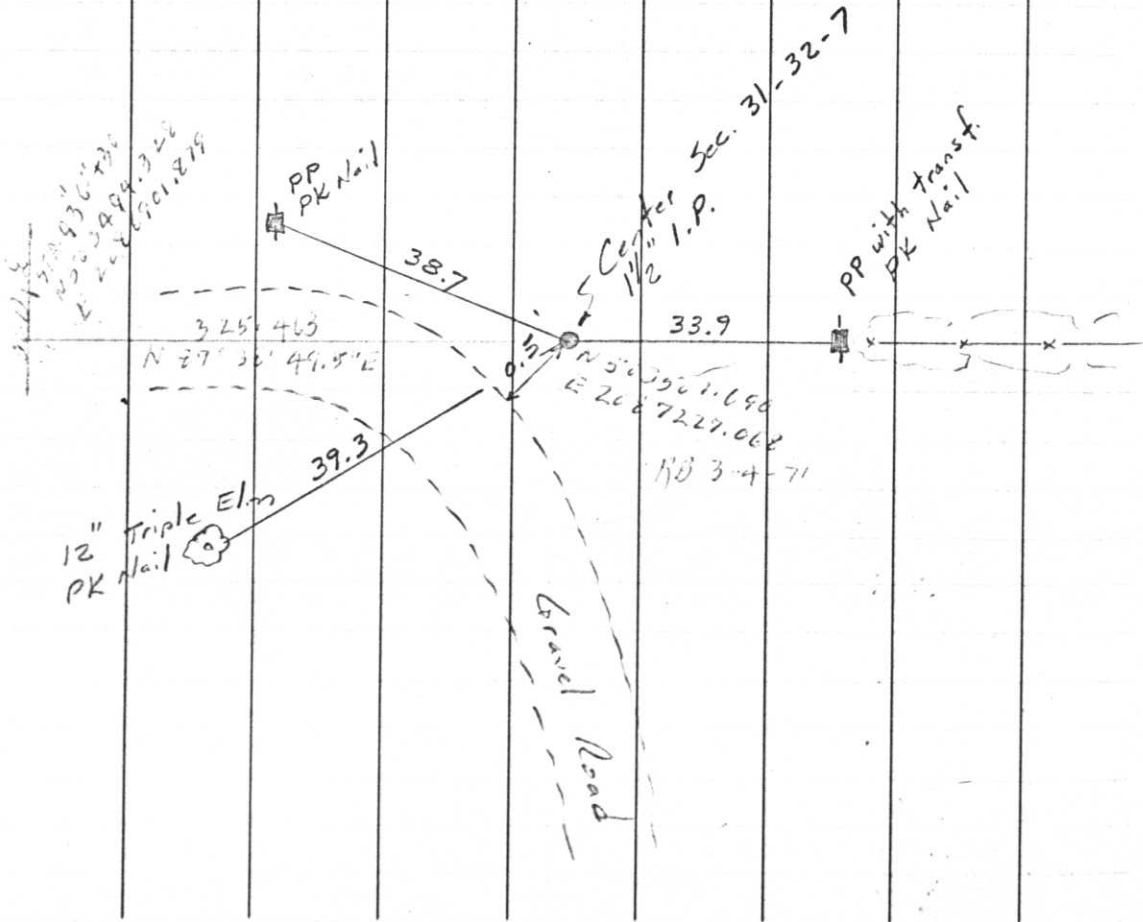

T32N

R7E

June 25, 1970

