

CERTIFIED LAND CORNER RESTORATION

Index No. A-23

State of Wisconsin }
 County of Lincoln } ss.

History of original corner establishment:

Wood post set by original government surveyor.

I, Sheridan D. Schwark, do hereby certify that on the 1st day of December, 1980, I found evidence of the North 1/4 corner of Section 1 Township 31, North, Range 7 East, Fourth, Principal Meridian, as described hereon; and that from this evidence I established a new monument and accessories as described hereon to perpetuate the original location of this corner.



Description of corner evidence found:

We found a 6" x 6" x 36" red granite stone monument at an old, down fence intersection. The stone was scribed 1/4 S on top and was heaved up about 18" by frost. We reset the stone in its location leaving its top 6" above grade.

Resident witnesses:

.....

Description of monument and accessories I established to perpetuate the original location of this corner.

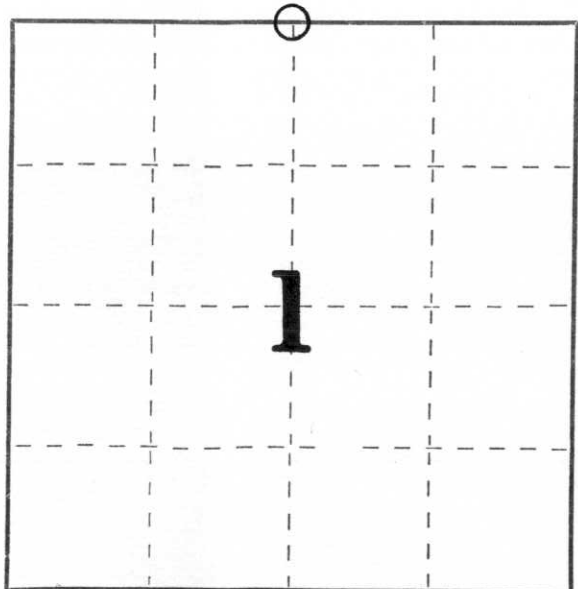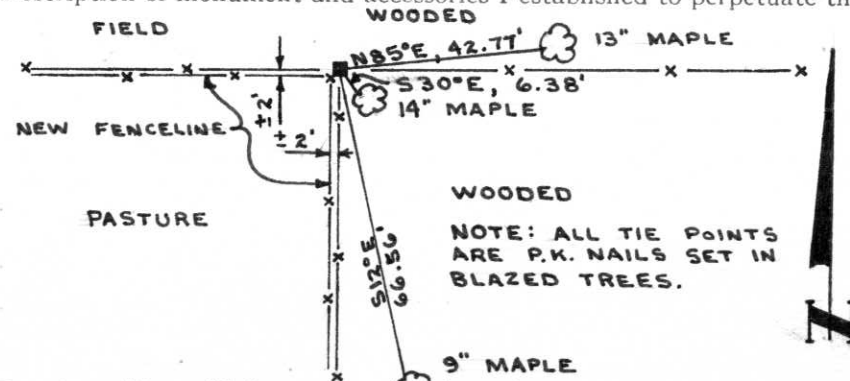

○ = Corner monument restored.

Dated at Merrill, Wis., this 12th day of December, 1980.

Signature Sheridan D. Schwark Title Registered Land Surveyor Registration No. S-1205
 (County Surveyor, Registered Land Surveyor, or other duly authorized official)

Office of Register of Deeds, County of _____, I hereby certify that the within instrument was filed in this office for record on the _____ day of _____, 19____ at _____ o'clock _____ M.

(Register of Deeds)

By _____ Deputy