

CERTIFIED LAND CORNER RESTORATION


Index No. E-5

State of Wisconsin }  
County of Lincoln } ss.

I, Lester J. Schmit, do hereby certify that on the 6th day of August, 1975, I found evidence of the Southeast corner of Section 6 Township 32, North, Range 8 East, Fourth, Principal Meridian, as described hereon; and that from this evidence I established a new monument and accessories as described hereon to perpetuate the original location of this corner.

Resident witnesses:

-----  
-----  
-----

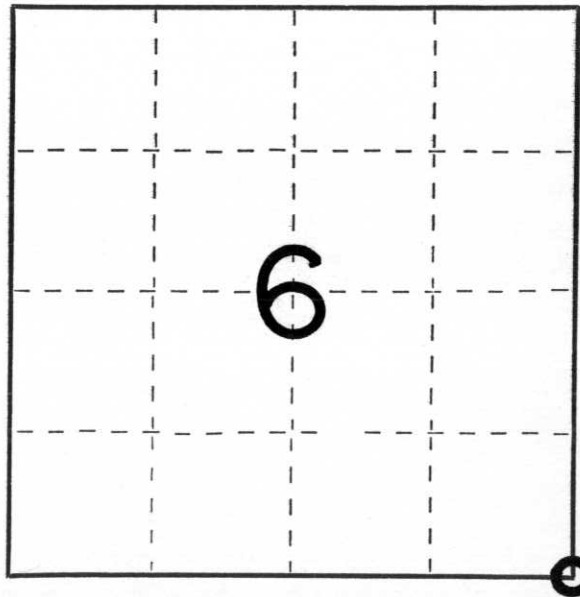

○ = Corner monument restored.

History of original corner establishment:

Surveyor: A.G. & F.S. Ellis

Date: 2 April 1852

Monumentation: Wood Post

Witnesses: Birch 10 S 25° W 17 links  
Birch 10 N 80° E 10 links

Description of corner evidence found: A granite monument, 6" x 6" x 30", 8" below the surface of a Town Road, set about 1912 by the Government to replace original wood post. This granite monument is in the centreline of said Town Road.

Description of monument and accessories I established to perpetuate the original location of this corner.

Berntsen Monument - 30" (Set 33.00' North of granite monument which is SE cor., Sec. 6) Berntsen Monument is to be Witness Corner to granite monument.

P.K. Nail in Power Pole N 42° E, 38.67'

1" dia. Iron Pipe S 58° E, 38.67'

1" dia. Iron Pipe S 45° W, 45.00'

Iron Pipe next to granite monument is for location purposes only.

Dated at Rhineland, Wis., this 15th day of November, 1975

Signature Lester J. Schmit Title Land Surveyor Registration No. S-1192  
(County Surveyor, Registered Land Surveyor, or other duly authorized official)

Office of Register of Deeds, County of \_\_\_\_\_, I hereby certify that the within instrument was filed in this office for record on the \_\_\_\_\_ day of \_\_\_\_\_, 19\_\_\_\_ at \_\_\_\_\_ o'clock \_\_\_\_\_ M.

\_\_\_\_\_  
(Register of Deeds)

By \_\_\_\_\_ Deputy



2002 7 3



2002 7 3



2002 7 3



2002 7 3